ANAND VIHAR
Redevelopment of Meadow Pointe Tract 14 Unit 3

Preliminary Development Plan / Preliminary Site Plan / Construction Plans

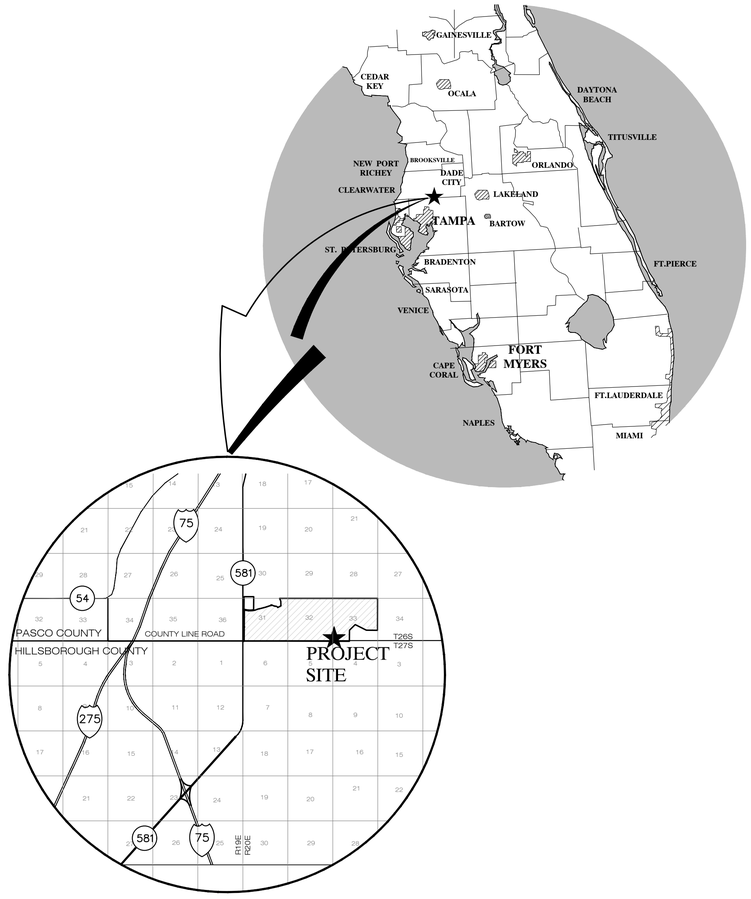

VICINITY MAP
PASCO COUNTY, FLORIDA
SECTIONS 32 & 33, TOWNSHIP 26 SOUTH, RANGE 20 EAST

LEGAL DESCRIPTION:

MEADOW POINTE PARCEL 14 - UNIT 3

DESCRIPTION: A parcel of land lying in the Southeast 1/4 of Section 32, Township 26 South, Range 20 East, and the Southwest 1/4 of Section 33, Township 26 South, Range 20, Pasco County, Florida, and being more particularly described as follows:

BEGINNING at the Southeast corner of Section 32, Township 26 South, Range 20 East, Pasco County, Florida and run thence N.89°50'36"W., 1314.55 feet along the South boundary of the Southeast 1/4 of said Section 32 to the Southeast corner of MEADOW POINTE PARCEL 8 UNIT 7, according to the plat thereof as recorded in Plat Book 36, Pages 1 through 5, inclusive, Public Records of Pasco County, Florida; thence N.23°00'00"W., 948.32 feet along the Easterly boundary of said plat of MEADOW POINTE PARCEL 8 UNIT 7 to the Southwest corner of MEADOW POINTE PARCEL 11 UNIT 2, according to the plat thereof as recorded in Plat Book 36, Pages 85 through 89, inclusive, Public Records of Pasco County, Florida; thence along the Southeasterly boundary of said plat of MEADOW POINTE PARCEL 11 UNIT 2, the following three (3) courses: 1) N.67°00'00"E., 557.98 feet; 2) N.67°04'53"E., 456.36 feet; 3) N.28°00'00"E., 101.04 feet to the Southwest corner of MEADOW POINTE PARCEL 14 UNIT 1, according to the plat thereof as recorded in Plat Book 36, pages 101 through 105, inclusive, Public Records of Pasco County, Florida; thence along the Southerly boundary of said plat of MEADOW POINTE PARCEL 11 UNIT 1, the following six (6) courses: 1) S.83°40'26"E., 861.59 feet; 2) S.49°45'05"E., 25.42 feet; 3) S.65°46'46" E., 36.32 feet; 4) S.50°20'14"E., 44.10 feet; 5) S.79°30'44"E., 39.95 feet; 6) S.74°40'18"E., 78.60 feet to a point on a curve on the Westerly right-of-way line of Mansfield Boulevard as recorded in O.R. Book 4594, page 415, Public Records of Pasco County, Florida; thence along the Westerly right-of-way line of said Mansfield Boulevard, the following four (4) courses: 1) Southerly, 159.81 feet along the arc of a curve to the right having a radius of 1960.00 feet and a central angle of 04°40'18" (chord bearing S.17°39'51"W., 159.76 feet) to a point of tangency; 2) S.20°00'00"W., 300.00 feet to a point of curvature; 3) Southerly, 541.05 feet along the arc of a curve to the left having a radius of 1240.00 feet and a central angle of 25°00'00" (chord bearing S.07°30'00"W., 536.77 feet) to a point of tangency; 4) S.05°00'00"E., 213.85 feet to the South boundary of the aforesaid Section 33, Township 26 South, Range 20 East; thence along the South boundary of the Southwest 1/4 of said Section 33, N.89°52'26"W., 151.70 feet to the POINT OF BEGINNING.

Containing 47.844 acres, more or less.

INDEX OF CONSTRUCTION PLANS

SHEET NO.	DESCRIPTION
1	COVER SHEET
2	GENERAL NOTES
3A	PRELIMINARY DEVELOPMENT PLAN
3B	PRELIMINARY SITE PLAN
4–7	DEMOLITION PLAN
8–11	GRADING & DRAINAGE PLAN
12–14	PAVEMENT & DRAINAGE DETAILS
15–18	WATER & SEWER PLAN
19	WATER SYSTEM DETAILS
20	SANITARY SEWER SYSTEM DETAILS
	SURVEY
	EXISTING STRUCTURE DATA SHEET
	SIGNING & PAVEMENT MARKING PLAN
	OFFSITE ROADWAY MODIFICATION PLAN
	EXISTING EASEMENT EXHIBIT
	LANDSCAPE PLANS
	POST DEVELOPMENT DRAINAGE MAP
	CROSS SECTIONS

David Fuxan

Digitally signed by David Fuxan
DN: c=US, st=Florida, l=Odessa, o=Fuxan Engineering Inc, cn=David Fuxan, email=dfuxan@fuxaneng.com
Date: 2020.06.13 11:01:19 -04'00'

DAVID G. FUXAN LICENSE No. 33133 STATE OF FLORIDA PROFESSIONAL ENGINEER

PERMIT / FILE NOS.	
SITE ADDRESS	
WATER COMMITMENT	PCU#96-102.33
SEWER COMMITMENT	
SWFWMD	
WATER DEP	
SEWER DEP	
PARCEL ID NO.	
RELATED PASCO COUNTY APPROVAL NUMBERS	

CALL 48 HOURS BEFORE YOU DIG
IT'S THE LAW! DIAL 811
811 Know what's below. Call before you dig.
SUNSHINE STATE ONE CALL OF FLORIDA, INC.

ANAND VIHAR

Prepared For:

Anand Vihar, LLC,
a Delaware LLC

Eric Eisenberg
4600 West Cypress Blvd.
Suite 120
Tampa, Florida 33607
Phone: (813) 546-7592
eric@mji-asset.com

DATE	SHEET NO.	BY
6/12/2020	15. REVISED SHEETS 3A, 3B, REMOVED AMENITY CENTER PHASING PLAN	JS
5/11/2020	14. ADD AMENITY CENTER PHASING PLAN	JS
3/24/2020	13. MINOR MODIFICATION SHEETS 2,3A,3B, 8–11, 15–18	JS
1/04/2018	12. REVISE SHEETS 2, 15–19	JS
12/08/2017	11. REVISE SHEETS 3A, 3B, 8–11	JS
11/29/2017	10. REVISE SHEETS 15–19	JS
10/25/2017	9. REDESIGN – REVISE SHEETS 3–11,15–18, CROSS SECTIONS	JS
3/06/2017	8. REVISE SHEETS 15–18	JS
12/16/2016	7. REVISE SHEETS 3A,B, 4, 5, 8–11, CROSS SECTIONS	JS
10/03/2016	6. REVISE SHEETS 3A,B, 8–11,15–18, POST DRAINAGE MAP	JS
9/22/2016	5. REVISE SHEETS 3A,B, 4,7,8,11,15,18, SIGNAGE, POST DRAINAGE MAP	JS
8/02/2016	4. REVISE SHEETS 1, 3(A), ADD SHEET 3B	JS
6/27/2016	3. REVISE SHEETS 8–11, ADD POST DEV. DRAINAGE MAP, CROSS SECTIONS SHEETS	JS
5/20/2016	2. REVISE SHEETS 3, 5, 8–11, 12, 15–18, 19, LANDSCAPE, EXISTING STRUCTURE DATA SHEET	JS
3/15/2016	1. REVISE SHEETS 2–11,15–18, LANDSCAPE, SIGNING & MARKING PLANS, ADD SURVEY, EXISTING STRUCTURE DATA SHEET	JS

REVISIONS

Fuxan Engineering, Inc.
15018 Maurine Cove Ln.
Odessa, Florida 33556
Phone: 813-244-6194
email: dfuxan@fuxaneng.com
Engineering Business Certificate of Authorization No.: 26548

DAVID G. FUXAN | FLORIDA PROFESSIONAL ENGINEER | 33133

DATE: DECEMBER 18, 2015 | JOB NO. 2015–MP–01

Elevations based on National Geodetic Vertical Datum 1929 (NGVD 29)
Conversion from NGVD 29 to NAVD 88 = -0.83 Feet

DESIGNED BY: FUXAN | DRAWN BY: SOMERVILLE

FILE: 1 CV

STORM WATER POLLUTION PREVENTION PLAN

Contained on these plans and within the following notes is a Storm Water Pollution Prevention Plan (SWPPP) which has been developed by Fuxan Engineering, Inc. in accordance with the Florida Department of Environmental Protection's (FDEP) "National Pollutant Discharge Elimination System" (NPDES) Generic Permit for Stormwater Discharge from Large and Small Construction Activities.

The following entities are identified as team members of "SWPPP": Fuxan Engineering, Inc., the Developer as identified in the title box of these plans, and the site contractor and his sub-contractors. Each team member has specific responsibilities and obligations. In general, all team members, with regard to their involvement and responsibilities on the project, are to implement all necessary storm water management controls to assure compliance with the NPDES Generic Permit for Storm Water Discharges from Construction Activities, the Southwest Florida Water Management District Permit, the applicable local governing agency (i.e. Hillsborough County, City of Tampa, etc) and the guidelines listed in the SWPPP. The duties and responsibilities of the team members as they pertain to the SWPPP are as follows:

Fuxan Engineering, Inc.

A. Develop SWPPP including, but not limited to, retention/detention ponds, control structures, erosion control methods and locations and stabilization criteria. This design is included within these construction plans and the following notes and instructions.

B. Submit and obtain the necessary design related storm water permits from the Florida Department of Environmental Protection, the Southwest Florida Water Management District and other applicable governmental bodies.

C. Upon notification by the developer of his intent to commence construction, submit a Notice of Intent to the FDEP on behalf of the developer and copy the contractor including SWPPP certification and copy of the permit.

D. Submit to SWFWMD and the operator of the municipal separate storm water system, if applicable, a letter of construction commencement.

E. Complete and submit a Notice of Termination and certification for developer. The NOT's shall be submitted no more than 30 days after
(a) completion of the project and final stabilization of the site or
(b) when responsibility for the site has ended. Final stabilization as defined by EPA is when all soil disturbing activities at the site have been completed and a uniform perennial vegetative cover (not less bare areas) perennial vegetative cover with a density of 70% of the native background vegetative cover for the area has been established on all unpaved areas and areas not covered by impervious surfaces. As an alternative, equivalent permanent stabilization measures (such as riprap, gabions, or geotextiles) may be employed. The client shall notify Fuxan Engineering, Inc. when one of these criteria has been met.

Contractor

A. Sign and return to Fuxan a Contractors Certification Form certifying your understanding of and willingness to comply with the Storm Water Pollution Prevention Plan no later than 48 hours prior to commencement of construction. Also, each subcontractor covered by the SWPPP must certify to the contractor that they understand and shall comply with the NPDES permit and SWPPP. A record of these certifications shall be maintained by the contractor on site.

B. During construction, assure compliance with the designed Storm Water Pollution Prevention Plans prepared by Fuxan Engineering, Inc. and the NPDES Generic Permit for Storm Water Discharges from Large and Small Construction Activities.

C. Maintain a copy of the construction plans, which include the Storm Water Pollution Prevention Plan,the NOI, and all inspection reports and certifications on site.

D. Undertake all reasonable Best Management Practices (BMP's) to assure that silted or otherwise polluted storm water is not allowed to discharge from the site during all phases of construction. Stabilization BMP's that may be used include: temporary or permanent seeding, mulching, geotextiles, sodding, vegetative buffer strips, protection of trees and preservation of mature vegetation. Structural erosion and sediment control BMP's that may be used include: straw bale dikes, silt fences, earth dikes, brush barriers, drainage swales, check dams, subsurface drain, pipe slope drain, level spreaders, storm drain inlet protection, outlet protection, sediment traps, and temporary sediment basins. Detention ponds may also be used as temporary sediment basins. Additional BMP's that may need to be implemented include: providing protected storage areas for chemicals, paints, solvents, fertilizers, and other potentially toxic materials. Providing waste receptacles at convenient locations and providing regular collection of wastes, including building material wastes. Minimizing off-site tracking of sediments. Making adequate preparations, including training and equipment to contain spills of oil and hazardous materials. Complying with applicable state or local waste disposal, sanitary sewer or septic system regulations and the use of appropriate pollution prevention measures for allowable non-storm water components of discharge.

E. Notify Fuxan Engineering, Inc. and the developer in writing of any non-storm water pollution sources which are being stored, or otherwise used during the construction of the project, i.e., fertilizers, fuels, pesticides, other chemicals. This notification should be accompanied with the contractor's design and methods to prevent pollution run-off from these sources.

F. Develop a maintenance and inspection plan which includes, but is not limited to the following:

A. The specific areas to be inspected and maintained that includes all the disturbed areas and material storage areas of the site.

B. The erosion and sediment controls identified in the SWPPP to be maintained and inspected and those additional controls that the contractor deems necessary.

C. Maintenance procedures.

D. The procedure to follow if additional work is required or whom to call.

E. Inspections and maintenance forms.

F. The personnel assigned to each task.

The following shall be inspected a minimum of once a week or within 24 hours after 0.50 inches of rainfall:

Stabilization measures (once a month if fully stabilized).

Structural controls.

Discharge points.

Construction entrances and exits.

Areas used for storage of exposed materials.

An inspection form shall be completed for each inspection. Any permit violations should be noted and corrective measures shall be taken no later than 7 days after the inspection occurred. If revisions to the SWPPP are needed, a report form for changes in the SWPPP shall be completed and a copy sent to Fuxan Engineering, Inc. The original shall be kept on-site as documentation of the change. If the inspection passes, a certification that the facility is in compliance with the SWPPP and the NPDES permit must be signed by a duly authorized representative of the principal executive official of the operator of the SWPPP with one of the following qualifications:

1. *Has successfully completed the Florida Stormwater, Erosion and Sediment Control Inspector Training Program.*
2. *Successfully completed a similar training program.*
3. *Has enough practical on the job training to be qualified to perform the inspections.*

Retain inspection reports and certifications for at least three years.

G. Site stabilization measures shall be initiated as soon as practical but in no case more than 7 days, in portions of the site where construction activities have temporarily or permanently ceased.

H. Releases in Excess of Reportable Quantities.

1. *The discharge of hazardous substances or oil in the stormwater discharge(s) from a facility or activity shall be prevented or minimized in accordance with the applicable stormwater pollution prevention plan for the facility or activity. This permit does not relieve the operator of the reporting requirements of 40 CFR part 117 and 40 CFR part 302. Where a release containing a hazardous substance in an amount equal to or in excess of a reporting quantity established under either 40 CFR 117 or 40 CFR 302, occurs during a 24 hour period:*
   a. *The operator is required to notify the State Warning Point (800–210–0519 or 850–413–9911) as soon as he or she has knowledge of the discharge;*
   b. *The operator shall submit within 14 calendar days of knowledge of the release a written description of: the release (including the type and estimate of the amount of material released), the date that such release occurred, the circumstances leading to the release, and remedial steps to be taken, to the Florida Department of Environmental Protection, NPDES Stormwater Section, Mail Station 2500, 2600 Blair Stone Road, Tallahassee, Florida 32399–2400; and*
   c. *The stormwater pollution prevention plan required under Part V of this permit must be modified within 14 calendar days of knowledge of the release to: provide a description of the release, the circumstances leading to the release, and the date of the release. In addition, the plan must be reviewed to identify measures to prevent the reoccurrence of such releases and to respond to such releases, and the plan must be modified where appropriate.*
2. *This permit does not authorize the discharge of hazardous substances or oil resulting from an on–site spill.*

Developer

A. Notify Fuxan Engineering, Inc. of your intent to commence construction. Sign the Notice of Intent form as operator of the storm water discharge facility and permittee and return to Fuxan Engineering, Inc.

B. Sign a Certification of Storm Water Pollution Prevention Plan and return to Fuxan Engineering, Inc.

C. Notify Fuxan Eng. when it is time to submit a Notice of Termination as defined under Part E of the Fuxan Engineering, Inc. section of the SWPPP. Sign and return to Fuxan Engineering, Inc. for submittal to FDEP a Notice of Termination form and certification.

PRE–DEVELOPED SITE INFORMATION:

1. *Total site acreage:* 47.8
2. *Land use:* Partially Developed
3. *Vegetation:* BAHIA GRASS
4. *Receiving waters or municipal separate storm water system:* CLAY GULLY
5. *2 Year/24 Hour rainfall depth:* 4.3
6. *Soil types:* EAU GALLIE FINE SAND

PROJECT INFORMATION:

1. *Project type:* COMMERCIAL
2. *Anticipated construction sequence is as follows:*
   1. *Complete erosion control installation*
   2. *Clearing and grubbing*
   3. *Earthwork activities*
   4. *Storm water system construction*
   5. *Utility construction*
   6. *Base and pavement construction*
   7. *Final stabilization*

The BMP's listed in Part D of the Contractor section of the SWPPP shall be considered during all phases of construction.

3. *Anticipated start date:* UNDER CONSTRUCTION
4. *Anticipated completion date:* DECEMBER 2020
5. *Total acres disturbed:* 10
6. *Pre–developed "C" factor:* 0.20
7. *Post–developed "C" factor:* 0.65
8. *The storm water management system, upon completion of construction and appropriate certification and as–built submittals will be operated and maintained by* Anand Vihar Condo Assoc.
9. *The potential source of pollution from this project is on–site development and construction activity.*

OWNER'S INSTRUCTIONS FOR MAINTENANCE
AND INSPECTION OF STORMWATER FACILITIES

The entire stormwater system should be inspected on at least a semi–annual basis. This should include a visual inspection of the pond, pond banks, bleed–down orifices, other control structures, and discharge pipes. These should be kept free of debris and cleaned on a frequency as required to keep them functional, as designed. Mowing/clearing around the structures may be required to prevent vegetation from clogging them.

Wetland plants, if intentionally installed, should be monitored and maintained as required on the approved construction plans. Areas of littoral shelving, which are required to be vegetated but not intentionally planted, should be observed for natural plant colonists. These areas should have as high a plant coverage as possible, for maximum water filtration.

Sediment sumps, if designed and installed, should have sediment removed as necessary to allow them to efficiently remove suspended particles. They should be re–dug to the original design specifications, if silted in.

For percolation treatment ponds/swales, the owner of the facility shall inspect the pond bottom periodically after heavy rainfall events to check for persistent ponding or pooling of water. All large debris shall be removed and disposed of elsewhere. If prolonged ponding persists, i.e., in excess of 72 hours, the owner shall rake or scarify the surface. If required, the soil in the area of ponding shall be removed and replaced with clean sandy, non–cohesive soils.

Please check the construction plans to see if written reports on monitoring or plant survival rates are required to be sent to any reviewing agencies. Written notes should also be kept which describe maintenance activities undertaken during each inspection.

Specific conditions of all permits may require additional maintenance activities above and beyond those outlined above. Please be aware of all permit conditions as issued by regulatory agencies to ensure permit compliance.

WETLAND NOTES:

1. *Before beginning any construction activities, including site preparation, the applicant shall clearly field–demarcate, in two different manners, both the wetland jurisdictional line and the 25' offset upland buffer line, as shown on the final, approved site plans.*
2. *All construction activities, including but not limited to, clearing, digging, ditching, grading, grubbing, trenching or installing erosion or sediment controls, shall occur upslope from the clearly field–demarcated 25' offset upland buffer line; no construction activities shall occur within the 25' offset upland buffer.*

SINKHOLE NOTES:

Should any noticeable soil slumping or sinkhole formation become evident, the applicant/developer shall immediately notify the County, Tampa Bay Water, and the Southwest Florida Water Management District (SWFWMD) and adopt one (1) or more of the following procedures as determined to be appropriate by the County and SWFWMD:

1. *If the slumping or sinkhole formation becomes evident before or during construction activities, stop all work (except for mitigation activities) in the affected area and remain stopped until the County and SWFWMD approve resuming construction activities.*
2. *Take immediate measures to ensure no surface water drains into the affected areas.*
3. *Visually inspect the affected area.*
4. *Excavate and backfill or grout, as required, to fill the affected area and prevent further subsidence.*
5. *Use soil reinforcement materials in the backfilling operation when appropriate.*
6. *If the affected area is in the vicinity of a water–retention area, maintain a minimum distance of two (2) feet from the bottom of the retention pond to the surface of the limerock or karst connection.*
7. *If the affected area is in the vicinity of a water–retention area and the above methods do not stabilize the collapse, relocate the retention area.*

GENERAL EROSION AND TURBIDITY CONTROL NOTES

1. *The Site Subcontractor shall be responsible for installation and maintenance of all erosion and turbidity controls and the quality and quantity of offsite or wetland discharges.*
2. *Prior to construction, the Site Subcontractor is responsible for having his dewatering plan and turbidity control plan approved by the applicable reviewing agencies. Refer to the project's permit approvals and permit conditions for agencies requiring such review and approval. Questions concerning appropriate techniques should be addressed to those agencies and/or discussed with the project engineer and owner.*
3. *The appropriate turbidity and erosion control methodologies selected by the Site Subcontractor for this project should be made following assessment of the plans and project site specific factors and after consultations as needed with the project engineer and appropriate agencies. The Site Subcontractor will be responsible for obtaining any and all necessary permits for such activity; several factors to consider are listed below:*
   A. *Clay content in excavated materials and/or permeabilities rates*
   B. *Depth of cut in ponds, trenches, or utility lines*
   C. *Ambient ground water table*
   D. *Actual rainfall amounts and time of year relative to normal rainy season*
   E. *Proximity to wetlands, water bodies or offsite properties*
   F. *'Class' designation of receiving water bodies (i.e., Outstanding Florida Waters, shellfish harvesting areas, etc.)*
   G. *Density, type, and proximity of upland vegetation to be retained during construction (for use as possible filtration areas)*
   H. *Fill height relative to natural grade and length and steepness of the proposed slopes*
   I. *Existing topography and directions of surface flow*
   J. *Type of equipment used*
   K. *Project type*
   L. *Duration of construction activities*
   M. *Separation distance of onsite ponds*
   N. *Ambient quality of surface and groundwater*
   O. *Temporary stockpile location and heights*
4. *At the onset of construction, the Site Subcontractor, as the party responsible for implementation of the erosion and sediment control plan, shall assess the above described conditions and begin with respect to effective cost effectiveness and select the appropriate methods of protection. A fairly extensive list of techniques are presented below but it must be stressed that any or all the following may be necessary to maintain water quality and quantity standards. The construction sequencing should be thought out in advance of initiation to provide adequate protection of water quality.*
5. *Discharges which exceed 29 N.T.U.'s over the background levels are in violation of state water quality standards. Ranges of water quantities which affect offsite properties or may damage wetlands are also prohibited by regulating agencies.*
6. *The erosion and turbidity control measures shown hereon are the minimum required for agency approval. Additional control and measures may be required due to the Site Subcontractor's construction sequence & unforeseen weather conditions. Any additional measures necessary by the Site Subcontractor shall be included in the lump sum bid with no extras for materials and labor allowed.*
7. *Hay bales or silt screens shall be installed prior to land clearing to protect water quality and to identify areas to be protected from clearing activities and maintained for the duration of the project until all soil is stabilized.*
8. *Floating turbidity barriers shall be in place in flowing systems or in open water lake edges prior to initiation of earthwork and maintained for the duration of the project until all soil is stabilized.*
9. *No clay material shall be left exposed in any stormwater storage facility. If clay or sandy–clays are encountered during stormwater storage excavation, the Site Subcontractor shall notify the Engineer immediately before proceeding with further excavation. If the Engineer of Record has determined that such soils are non–confining and must be excavated to meet permit and design conditions, excavation may proceed after obtaining written authorization from the appropriate governing agency.*
   If said soils are left exposed at the permitted and designed depth, the Site Subcontractor shall over–excavate the pond's bottom and side slopes by a minimum of twelve (12") inches and backfill with clean sands to help prevent suspension of fine particles in the water column.
10. *The installation of temporary erosion control barriers shall be coordinated with the construction of the permanent erosion control features to the extent necessary to assure effective and continuous control of erosion and water pollution throughout the life of the construction project.*
11. *The type of erosion control barriers used shall be governed by the nature of the construction operation and soil type that will be exposed. Silty and clayey material may require solid sediment barriers to prevent turbid water discharge, while sandy material may need only silt screens or hay bales to prevent erosion. Floating turbidity curtains should generally be used in open water situations. Diversion ditches or swales may be required to prevent turbid stormwater runoff from being discharged to wetlands or other water bodies. It may be necessary to employ a combination of barriers, ditches, and other erosion/turbidity control measures if conditions warrant.*
12. *Where pumps are to be used to remove turbid waters from construction areas, the water shall be treated prior to discharge to the wetlands. Treatment methods include, for example, turbid water being routed into grassed swales or appropriate upland vegetated areas (other than upland preservation areas and wetland buffers), sediment basins, or confined by an appropriate enclosure such as turbidity barrier or low berms, and kept confined until turbidity levels meet State Water Quality Standards.*
13. *The Permittee shall schedule his operations such that the area of unprotected erodible earth exposed at any one time is not larger than the minimum area necessary for efficient construction operation, and the duration of exposure, uncompleted construction to the elements shall be as short as practicable. Clearing and grubbing shall be so scheduled and performed such that grading operations can follow immediately thereafter. Grading operations shall be so scheduled and performed that permanent erosion control features can follow immediately thereafter if conditions on the project permit.*
14. *Water derived from various dewatering methods should be passed through sufficiently wide areas of existing upland vegetation to filter out excess turbidity. If this is not sufficient, the water shall be retained in previously constructed permanent stormwater ponds or else retained in temporary sedimentation basins until the clarity is suitable to allow for its discharge. Plugging the outfalls from completed stormwater ponds may be needed to avoid discharge. However, such situations should be monitored closely to preclude berm failure if water levels rise too high.*
15. *Water can be transported around the site by the use of thermal swales or by pumps and pipes.*
16. *Sheet flow of newly filled or scraped areas may be controlled or contained by the use of brush barriers, diversion swales, interceptor ditches or low berms. Flow should be directed toward areas where sediments can sufficiently settle out.*
17. *Exposed soils shall be stabilized as soon as possible, especially slopes leading to wetlands. Stabilization methods include sold sod, seeding and mulching or hydromulching to a temporary or permanent grass cover mulch blankets, filter fabrics, etc., can be employed to provide vegetative cover.*
18. *Energy dissipaters (such as rip rap, a gravel bed, hay bales, etc.) shall be installed at the discharge point of pipes or swales if scouring is observed.*
19. *Attempt to install roadway curb and gutters as soon as possible to reduce the surface area for erosion to occur.*
20. *Implement storm drain inlet protection (hay bales or gravel) to limit sedimentation within the stormwater system. Perform inspections and periodic cleaning of sediments which wash out into the streets until all soil is stabilized.*
21. *Water discharge velocities from impounded areas and temporary sedimentation basins shall be restricted to avoid scouring in receiving areas.*
22. *If water clarity does not reduce to standards by rapidly enough in holding ponds, it may be possible to use chemical agents such as alum to flocculate or coagulate the sediment particles.*
23. *Hay bales, silt screens, or gravel beds can be added around the pipe or swale discharge points to help clarify discharges. Spreader swales may help dissipate cloudy water prior to contact with wetlands.*
24. *All fuel storage areas or other hazardous storage areas shall conform to accepted state or federal criteria for such containment areas.*
25. *Vehicle or equipment washdown areas will be sufficiently removed from wetlands or offsite areas.*
26. *Fugitive dust controls (primarily by using water spray trucks) shall be employed as needed to control windborn emissions.*
27. *If the above controls remain ineffective in precluding release of turbid water, especially during pond or utility line dewatering, then the contractor may be compelled to use a vertical dewatering system such as well points or sock drains to withdraw groundwater which may already be clear enough to allow for direct discharge to wetlands.*
28. *Ongoing inspections and periodic maintenance by the Site Subcontractor shall occur throughout construction as necessary to insure the above methods are working suitably. This may be needed daily, if conditions so warrant. Site Subcontractors are encouraged to obtain and thoroughly review The Florida Development Manual: A Guide to Sound Land and Water Management, which was developed by the State of Florida Department of Environmental Protection in 1988. This provides fairly in–depth discussions of recommended techniques and also provides specific design and technical standards. A copy of this document is available for review at Fuxan Engineering, Inc.*
29. *The contractor will perform daily inspections of all on–site wetlands within the construction area to ensure that water levels within those wetlands are not excessively impounded prior to the time when the permitted control structure or outfall is built. Water levels significantly above normal should be corrected at a frequency that prevents a change in the vegetative character or health of any wetlands.*

WATER, SEWER & RECLAIMED WATER CONSTRUCTION NOTES:

1. *Prior to construction, the Contractor shall obtain from the Engineer or Owner a copy of all pertinent permits related to this project. It is the Contractor's responsibility to assure that all construction activities are in compliance with the conditions of all permits and approvals.*
2. *Grass and mulch, or solid sod, all areas in existing rights–of–way disturbed by construction.*
3. *Contractor is to coordinate all work within, but not limited to, Pasco County rights–of–way with utility companies in order to prevent damage to utility lines and the making of adjustments to same, if required.*
4. *All utility system–design materials and workmanship shall comply with Standards for Design and Construction of Water, Wastewater and Reclaimed Water Facilities Specs., Latest Edition.*
5. *Contractor shall be responsible for obtaining any and all road crossing or utility permits.*
6. *The existing underground utility lines shown hereon were taken from documents furnished by others and not field verified, therefore, the Engineer cannot guarantee the accuracy of same nor that all are shown. The Contractor shall expose all underground lines in coordination with the Owners to his satisfaction and make adjustments to same in the event there are conflicts with new construction.*
7. *Contractor shall verify locations and depths of existing water and sewer lines prior to beginning construction.*
8. *The locations and elevation of all service lines are to be determined in the field by Owner and/or Contractor prior to construction of same.*
9. *Fire hydrant, gate valve and blow–off valve assemblies shall consist of all pipe, valves, tees, fittings, and any and all other appurtenances comprising a complete, working unit.*
10. *All fire hydrants shall be flow tested and color coded based of flow results.*
11. *All 4"–12" PVC water main pipe shall be C–900, DR 18, conforming to the requirements found in AWWA Standard, latest edition at the time of plan approval. 16" water main shall be C–905 DR 25 PVC. All service pipe less than 4" in diameter shall be PVC Pressure Rated for Pressure Rate 200; DR 21 per ASTM Standard D–2241. Water mains smaller than 2" in diameter shall be Class 1120 or 1220 ; Schedule 80 and meet the requirements of ASTM D–1785.*
12. *All water main pipe and fittings installed under this project shall be color coded or marked in accordance with subparagraph 62–555.320(21)(b)3, Florida Administrative Code, based on the following color code.*
13. *Reclaimed water mains, valves, and services shall include the following to avoid confusion with potable systems:*
   A. Purple pigmented C–900, DR–18 PVC piping for 4"–12" reclaimed water mains, except 2" which shall be SDR 21 PVC piping.
   B. Square top valve boxes for isolation valves in system, with covers marked "Effluent."
   C. Purple stripe on curb to identify reclaimed water services.
   D. One–inch purple services for reclaimed water.
   E. Purple magnetic locating tape, stating "REUSE MAIN BURIED BELOW" over all reclaimed water mains (18 inches below grade).
   F. Reclaimed water service on opposite lot line from potable service.
   G. 16" reclaimed main shall be C–905 DR 25 PVC.
14. *All aspects of reclaimed water system must comply with Chapter 17–610, F.A.C., latest edition.*
15. *All 8" sanitary sewer pipe shall be constructed at a 0.40% minimum slope unless otherwise noted.*
16. *Force mains shall be constructed of C–900 DR 18 PVC pigmented green.*
17. *Adjusting manhole tops to match grade and slope of the finish paving shall be included in the respective contract unit price for manholes, payment of which will constitute full compensation for the construction and completion of the manhole, and no additional payment will be allowed or made for adjusting manhole tops.*
18. *Bends shall be installed in force main or water main to avoid unforeseen conflicts in existing or proposed structures.*
19. *The joint deflection method shall be used where practical in lieu of installing bends.*
20. *All valve box assemblies located within roadways or parking areas shall be protected from truck traffic by use of 6" thick reinforced concrete pads poured around valve boxes (see detail).*
21. *Connections into existing county–owned systems shall be via wet tap. Wet taps shall be performed exclusively by the Pasco County Utilities Services Branch at the developer's expense. Material for wet taps larger than 2" shall be provided and installed by the project contractor. Excavation, backfill and surface restoration shall be the contractor's responsibility. Material for wet taps larger than 2" shall be provided and installed by the project contractor.*
22. *Gate valves installed for phasing shall be restrained per current Pasco County standards.*
23. *Off–road utility easements shall be "stabilized" for access by maintenance vehicles.*
24. *Blow–off valves on the water main, force main, and reclaimed main shall have restrained joints from the main line to the stub–out.*
25. *All PVC pressure pipe shall have a minimum 36" cover.*
26. *Maintain 5' minimum horizontal separation between reclaimed mains or water mains or force mains.*
27. *All water mains shall be deflected vertically where crossing storm sewer pipe to obtain a minimum vertical distance of 18" between the outside of the water main and the outside of the storm sewer. Joints shall be located such that the distance from the storm sewer and water main joint is as far as practical.*
28. *Water mains should be laid at least 10 feet horizontally from any existing or proposed storm sewer.*
29. *At no time should horizontal clearance between force main or gravity sewer and water main be less than 18" at crossing of same.*
30. *At no time should horizontal clearance between force main or gravity sewer and water main be less than 10' when same are paralleling each other.*
31. *Sanitary sewers, force and reclaimed mains and storm sewers should cross under water mains. Sanitary sewers, force and reclaimed mains and storm sewers crossing water mains shall be laid to provide a minimum vertical distance of 18 inches between the invert of the upper pipe and the crown of the lower pipe whenever possible.*
32. *When sanitary sewers, force and reclaimed mains and storm sewers must cross a water main with less than 18 inches vertical distance, both the sewer and the water main shall be constructed of ductile iron pipe (DIP) at the crossing. (DIP is not required for storm sewers if it is not available in the size proposed.) Sufficient lengths of DIP must be used to provide a minimum separation of 10 feet between any two joints. All joints on the water main within 20 feet of the crossing must be leak free and mechanically restrained. A minimum vertical clearance of 6 inches must be maintained at the crossing.*
33. *Where there is no alternative to sewer and reclaimed pipes crossing over a water main, the criteria for minimum separation of 18 inches vertical and 10 feet between joints shall be required.*
34. *All crossings shall be arranged so that the sewer and reclaimed pipes joints and the water main pipe joints are equidistant from the point of crossing (pipes centered on the crossing).*
35. *Where a new pipe conflicts with an existing pipe, the new pipe shall be constructed of DIP and the crossing shall be arranged to meet the requirements above.*
36. *A minimum 10–foot horizontal separation shall be maintained in parallel installations between any type of sewer (including drainage inlets) and water main whenever possible. A minimum 5–foot horizontal separation shall be maintained in parallel installation between reclaimed water mains and water mains, and between reclaimed water mains and sanitary sewers whenever possible.*
37. *In cases where it is not possible to maintain a 10–foot horizontal separation between any type of parallel sewer and water main, or a 5–foot separation between reclaimed main and water main, the water main must be laid in a separate trench or on an undisturbed earth shelf located on one side of the sewer, reclaimed main, or force main at such an elevation that the bottom of the water main is at least 18 inches above the top of the sewer.*
38. *Where it is not possible to maintain a vertical distance of 18 inches or a horizontal distance of 10 feet in parallel installations, the water main shall be constructed of DIP and the sewer, reclaimed main, or force main shall be constructed of DIP (if available in the size proposed) with a minimum vertical distance of 6 inches. The water main should be above the sewer, reclaimed main, or force main. Joints on the water main shall be located as far apart as possible from joints on the sewer, reclaimed main, or force main (staggered joints).*
39. *All subsurface construction shall comply with the "French Safety Act." The Contractor shall insure that the method of trench protection and construction is in compliance with the Occupational Safety and Health Administration (OSHA) Regulations.*
40. *The Utilities Services Branch shall not own or maintain onsite water lines, sewer lines, or facilities.*
41. *"Contractor's Responsibilities regarding wet taps two inches and larger shall be as follows:*
   A. 2" Only: This excavated trench must be dry or the trench will require rock and a pump to be in place. The minimum distance from the face of the valve to the wall of the trench is to be six feet. The County will provide the tapping saddle, corporation stop, stainless steel nipple, and iron body valve.
   B. 3" and Larger: The contractor will supply a tapping saddle being epoxy coated, a tapping valve with mechanical joint and the equipment to provide, and conduct a pressure test. County personnel will witness the pressure test which must be at 150 psi for duration of thirty minutes.
   C. The contractor is responsible for the excavation before any County personnel will enter an excavated area. If the trench is four feet in depth or deeper, it will require a trench box or sloping, and a ladder according to Occupational Safety and Health Administration (OSHA) standards.
   D. The tapping valve will require a blocking device made of suitable material or device. This blocking device or material will be placed under the valve and remain in place until the tap machine is removed and the tap is completed.
   E. Note: If the contractor has not fulfilled his responsibilities, as stated above, prior to the arrival of Pasco County Utilities Operations and Maintenance tapping crew, there will be an additional charge of $96.00. If you have any questions regarding this information, contact Nelson D. Holt, Maintenance Supervisor, Utilities Services Branch, at (813) 235 6189, or e–mail nholt@pascocountyfl.net.

STREET & DRAINAGE CONSTRUCTION NOTES:

1. *Prior to construction, the Contractor shall obtain from the Engineer or Owner a copy of all pertinent permits related to this project. It is the Contractor's responsibility to assure that all construction activities are in compliance with the conditions of all permits and approvals. Contractor is also responsible for having his dewatering plan approved by SWFWMD.*
2. *All construction, materials and workmanship are to be in accordance with Pasco County Land Development Code and DOT specifications, latest editions.*
3. *Grass and mulch, or solid sod, all areas in existing rights–of–way disturbed by construction. In the proposed rights–of–way a 16" wide area behind the back of curb shall be solid sodded. The remainder of the proposed rights–of–way to be seeded and mulched if the slope is greater than 6:1.*
4. *Contractor is to coordinate all work within, but not limited to Pasco County rights–of–way with utility companies in order to prevent damage to utility lines and making of adjustments to same, if required.*
5. *(For Miami, Valley, Type "V", etc. Gutter Type Sections Only) Prior to curb inlet construction, the Engineer shall lay out the back of the curb in the vicinity of the respective inlet for alignment and grade, and the Contractor shall construct the inlet allowing for an 18" concrete throat between the back of the curb and the face of the inlet. The top of the inlet shall be constructed to an elevation of 3/8" above the top of curb. Any inlets constructed incorrectly by deviating from this sequence of inlet construction shall be the sole responsibility of the Contractor and no additional payment shall be made or allowed for removing and/or correcting the inlet.*
6. *Suitable fill obtained through excavation of streets and detention ponds shall be placed on lots and adjacent land in accordance with the Master Drainage and Grading Plan as directed by the Engineer.*
7. *Sod/Seed & Mulch shall be placed in accordance with applicable City/County standards as well as in accordance with standard and specific conditions in the SWFWMD permit, if applicable. At a minimum this shall include sodding of all pond embankments of a slope 4:1 or greater to the NW line, as well as seeding and mulching of the balance of the pond tracts (including pond berms, excluding the area below NW), sodding at a minimum of 16" from the back of curb, and seeding and mulching of any remaining area with a slope of 4:1 or steeper.*
8. *Roadway underdrain has been located on these plans to ensure adequate base protection. Prior to curb construction, the Geotechnical Engineer shall review the pregrade subgrade and, along with their field inspection, make a recommendation regarding additional underdrain requirements.*
9. *Site clearing shall be performed per the approved construction plans and in accordance with Pasco County Land Development Code. Installation and maintenance of the required barricading and erosion control shall be the responsibility of the site development contractor unless otherwise designated.*
10. *Prior to beginning construction, Contractor shall expose all existing utility inverts to which a tie–in is proposed and have Engineer verify the elevation and adequacy of these inverts.*
11. *All subsurface construction shall comply with the "French Safety Act." The Contractor shall ensure that the method of trench protection and construction is in compliance with the Occupational Safety and Health Administration (OSHA) regulations.*
12. *Siltation accumulations greater than the lesser of 12 inches or one–half the depth of the siltation barrier shall be immediately removed and placed in upland areas.*
13. *During land alteration and construction activities, it shall be unlawful to remove vegetation by grubbing except for silt soil deposits, debris, solvents, construction material, machinery or other equipment of any kind within the dripline of a tree to remain on the site unless otherwise approved by the County.*
14. *All erosion control installation and installation coordination shall be the responsibility of the Contractor. Be advised that the construction approval and maintenance of the erosion control shall be the sole responsibility of the Site Contractor.*
15. *The Contractor must provide a Dewatering Plan, if applicable, to the Pasco County Utilities Engineering Inspections Branch, (727) 834–3670 for review prior to the erosion control measures pre–inspection meeting.*

STANDARD FIRE PROTECTION NOTES:

a. All projects must comply with Pasco County Fire Hydrant Ordinance No. 46–51.

b. Fire hydrants shall be installed and in service prior to the accumulation of combustibles.

c. Per the National Fire Protection Association, NFPA–1, 16.4.3.1.3: Where underground water mains and hydrants are to be provided, they shall be installed, completed, and in service prior to construction work.

d. Per NFPA–1, 18.3.4.1: Clearances of 7 1/2 feet in front of and to the sides of the fire hydrant with a 4 foot clearance to the rear must be maintained at all times.

e. Fire detector and smoke alarm are required in the sleeping rooms.

SPECIFICATIONS FOR DESIGN AND INSTALLATION OF TRAFFIC CONTROL DEVICES

1. *All traffic control devices shall be installed in conformance with the Federal Manual on Uniform Traffic Control Devices and the Florida Department of Transportation standards.*
2. *Street name signs shall be 6–inch on local roads and 9–inch on collector and arterial roads. 6–Inch signs shall have 4–inch series "C" letters and 9–inch signs shall have 6–inch series B letters. All street name signs on private roads (non–county maintained) shall be standard D3 street name signs with the colors reversed; white background with green letters and border. At intersections with county maintained roads; the county maintained road shall be green background with white letters and border.*
3. *Any traffic control device for a private roadway placed in a county or state Right–of–Way shall be installed on the appropriate breakaway post assembly.*
4. *All parking spaces shall be striped in white.*

TRACT DESIGNATION TABLE

TRACT	SIZE	DESIGNATION
"A"	3.50 Ac.	PRIVATE STREET RIGHT-OF-WAY; PUBLIC UTILITY AND DRAINAGE EASEMENT
"B"	0.51 Ac.	PARK AREA
"C"	0.14 Ac.	PARK AREA
"D"	0.18 Ac.	OPEN AREA; DRAINAGE AREA DRAINAGE EASEMENT (PRIVATE)
"E"	25.53 Ac.	OPEN AREA; DRAINAGE AREA DRAINAGE EASEMENT (PRIVATE); WETLAND CONSERVATION AREA: SWFWMD UPLAND PRESERVATION AREA "3B" (O.R. BOOK 5064, PAGE 1572)
"F"	1.39 Ac.	AMENITY CENTER

NOTE: TRACTS LABELED ON SHEETS 3A, 3B, AND ON PLAT

PCU#96–102.33

PASCO COUNTY STANDARD SITE PLAN NOTES:

1. Owner/Developer: Anand Vihar, LLC, a Delaware LLC
   3119 Mossvale Lane
   Tampa, FL 33607
   Ph. (561) 755–3635
   Engineer/Surveyor: Fuxan Engineering, Inc.
   15018 Maurine Cove Ln.
   Odessa, Florida 33556
   (813) 244–6194
3. Existing zoning: MPUD
4. Existing Land Use Classification: RES–3
5. The original MPUD Plan was approved on September 18, 1999, with last MPUD amendment GM 99–375 on October 24, 1973.
6. Water service to be provided by Pasco County Utilities.
7. Sewage disposal service to be provided by Pasco County Utilities.
8. Electrical power to be provided by TECO.
9. Telephone service to be provided by Verizon Florida, Inc..
10. Fire protection to be provided by the existing Pasco County Fire Station on the west side of Meadow Pointe.
11. The site is currently partially developed.
12. Predominant soil types on–site consist of Eau Gallie Sands within upland areas.
13. Detention ponds will be owned and maintained by the Anand Vihar Condo Association.
14. Contours shown are based on National Geodetic Vertical Datum 1929 (NGVD 29).
15. All roadway and sodded areas along collector roads will be irrigated.
16. All utility lines shall be installed underground and designed/ approved by the respective utilities.
17. Project lies within Flood Zones "X & AE" as shown on FIRM Panel No. 12101C0437F, dated September 26, 2014.
18. Unless otherwise shown, all sidewalks shall be five (5) feet wide, 4½" thick concrete, and 3000 p.s.i.
19. All easements to be a minimum of five (5) feet in width.
20. Medians and roadside clear zones shall be sodded or seeded & mulched.
21. All landscape and sodded areas along collector roads will be irrigated.
22. If during construction activities any evidence of historic resources, including but not limited to aboriginal or historic pottery, prehistoric stone tools, bone or shell tools, historic trash pits, or historic building foundation, are discovered, work shall come to an immediate stop and the Florida Department of Historic Resources (State Historic Preservation Officer) and Pasco County shall be notified within two working days of the resources found on the site.
23. The Anand Vihar Condo Association shall inspect and maintain the water detention system on a regular basis.
24. All sodded slopes over 4 to 1, shall be installed with sod pegs.
25. All demolition debris shall be removed from the site and legally disposed of.
26. The buildings shall have the finish floor elevation a minimum of 1' above the base flood elevation or as required by the Land Development Code.
27. Street lighting shall be provided per state and county regulations.
28. Fugitive dust shall be controlled by water trucks.
29. Geotechnical Engineer shall review the pregrade subgrade and,
30. The project drains into a proposed pond which drains to the Clay Gully.
31. Maximum building height per LDC is 45 feet. Proposed building height is 45 feet.
32. Project will be completed in one phase.
33. Installation of fuel storage tanks requires review and approval by the Fire Marshal and the issuance of a separate building permit. Approval of the site plan does not constitute approval of the location of the fuel tanks.
34. All proposed signs must be applied for, approved, and permitted on an individual basis apart from any ultimately approved site plan. Approval of this site plan does not constitute approval of any signage.
35.

ANAND VIHAR

PRESERVATION AREA "3B"
O.R. Book 5064, Page 1572

RES-3 MPUD

MEADOW POINTE PARCEL 14 UNIT 1
PB 36, PG 101-105

WCA I

EXISTING POND 1
DHW: 59.80
DLW: 58.30
DNW: 57.80

EXISTING POND 2
DHW: 59.80
DLW: 58.30
DNW: 57.80

EXISTING POND 3
DHW: 60.00
DLW: 58.50
DNW: 58.00

EXISTING POND 4
DHW: 61.55
DLW: 61.05
DNW: 60.05

EXISTING POND 1-1
DHW = 61.2
DLW = 59.7
DNW = 59.2

EXISTING POND
DHW = 61.5
DLW = 60.3
DNW = 60.0

15' DRAINAGE EASEMENT
10' SIDE YARD UTILITY EASEMENT (TYPICAL)
20' FRONT UTILITY EASEMENT (TYP.)
23.5' DRAINAGE EASEMENT
22.5' DRAINAGE EASEMENT
24' DRAINAGE EASEMENT
10' DRAINAGE EASEMENT
15' UTILITY EASEMENT
15' PRIVATE UTILITY EASEMENT
5' PRIVATE UTILITY EASEMENT
19' UTILITY EASEMENT EAST SIDE OF GODAVARI WAY
20' TYPE 'D' BUFFER
EMERGENCY GATE SHALL INCLUDE SOS OR 3M OPTICOM EQUIPMENT
20.0' LANDSCAPE WALL/ DRAINAGE EASEMENT
DRAINAGE EASEMENT (WIDTH VARIES)
DRAINAGE EASEMENT (WIDTHS VARY)
PUBLIC UTILITY EASEMENT
EROSION CONTROL (TYP.)
INSTALL UPLAND BUFFER SIGN (TYP. OF 10)
INSTALL UPLAND BUFFER SIGNS (TYP. OF 10)
SWFWMD WETLAND LINE
25' WETLAND BUFFER
UPLAND PRESERVATION EASEMENT
15' WETLAND BUFFER
20' TYPE 'D' BUFFER

FLOOD ZONE "AE" EL.60.73 (NGVD29) (59.9 NAVD88)
FLOOD ZONE "AE" EL.60.93 (NGVD29) (60.1 NAVD88)
FLOOD ZONE "AE" EL.61.73 (NGVD29) (60.9 NAVD88)
FLOOD ZONE "AE" EL.60.83 (NGVD29) (60.0 NAVD88)
FLOOD ZONE "X"

SINGLE FAMILY MODEL HOMES (TYPICAL - REF. HATCH) (SEE NOTE, THIS SHEET)

GANGA WAY
NARMADA WAY
SARASWATI WAY
YAMUNA WAY
ANAND VIHAR DRIVE
GODAVARI WAY
FOXFORD LANE
HADDINGTON
MANSFIELD BLVD. 80' R/W - COLLECTOR

TRACT A
TRACT E
TRACT F
PARK

TENNIS COURT
FLUSH CURB UNDER COVER
10,940 SF ONE-STORY CLUBHOUSE & AMENITY CENTER FF 65.0

#1 through #50 (2) 1- OR 2-STORY HOMES
#1A through #7C (2) 1- OR 2-STORY HOMES
#16A through #16C (2) 1- OR 2-STORY HOMES
#17A through #17C (2) 1- OR 2-STORY HOMES
#18A through #18C (2) 1- OR 2-STORY HOMES
#1A through #4B (2) 1- OR 2-STORY HOMES
#3A (2) 1- OR 2-STORY HOMES FF 62.4
#3B (2) 1- OR 2-STORY HOMES FF 62.4
12 LODGE VILLAS (EXISTING 2-STORY) FF 64.7
12 LODGE VILLAS (EXISTING 2-STORY) FF 63.4

3-UNIT REDUCTION TO 2-UNIT (TYP OF 12)
(4) 24'x10' PARALLEL PARKING SPACES
20'x9' PARKING SPACES (TYP.)
24'x10' PARALLEL PARKING SPACES
24.11O' PARALLEL SPACE (TYP.)
HC RAMP (TYP.)
EX. 5' SW
EX. 2' VALLEY GUTTER
EX. 33' PAVEMENT W/ 12' LANES W/ 2 ± BIKE LANES
EX. 8" SDR/AWWA BULK METER W/ SINGLE BFP (2) 45° BENDS, (2) 90° BENDS
EX. TRASH COMPACTOR
EX. FAUX GUARD HOUSE
EX. RETAINING WALL
EX. SIGN TOWER
EXISTING WETLAND MITIGATION
WETLAND "53" SH=60.05 NP=
MITIGATION AREA 25 45' ± 0.55 AC.± (HERBACEOUS)
LITTORAL AREA
LITTORAL ZONE
CLEAR SIGHT TRIANGLE PER PASCO COUNTY (TYP.)

42J SH=59.20 NP=58.45
25 SH=60.87 NP=60.32

WETLAND CONSERVATION AREA
WCA I
S.W.F.W.M.D. UPLAND PRESERVATION AREA "3B" O.R. Book 5064, Page 1572
WCA II

PRESERVATION AREA HIKING ALLOWED PROHIBITED ACTIVITIES INCLUDE MOWING, PRUNING, TRIMMING, AND PLACEMENT OF PIONING FACILITIES/ PARK AMENITIES

CLAY GULLY RES-3 MPUD

PASCO COUNTY
HILLSBOROUGH COUNTY

THE PROPERTY DOES NOT LIE WITHIN A HURRICANE EVACUATION ZONE

SEE SHEET 12 FOR TYPICAL LOT DETAIL

ALL SIDEWALK RAMPS TO BE CONSTRUCTED PER FDOT INDEX NO. 304

SEE SHEET 2 FOR PASCO COUNTY STANDARD SITE PLAN NOTES

MEADOW POINTE PARCEL 16 UNIT 3B
PB 47, PG 61-70

32 33

120 60 0 60 120
SCALE: 1" = 60'

LEGEND

EXISTING	PROPOSED	
		STORM DRAINAGE STRUCTURE
		STAKED EROSION CONTROL
		SWFWMD WETLAND LINE
		25' OFFSET FROM SWFWMD WETLAND LINE SHOWN FOR INFORMATIONAL PURPOSES
		ASPHALT PAVEMENT 167,706± S.F. (ON-SITE PARKING) 2,525± SF (DRIVEWAY)
		CONCRETE 138,327± S.F.
		PARK AREA ±260,161 S.F. (±5.97 Ac.)
		30' CLEAR SIGHT TRIANGLE PER PASCO COUNTY
		2014 FEMA FLOOD BOUNDARY
		PRELIMINARY SITE PLAN (PSP) ELEMENTS SHOWN ON SHEET 3B

Project lies within Flood Zones "X & AE" as shown on FIRM Panel No. 12101C0437F, dated September 26, 2014

BUILDING NOTE:
AS NOTED HEREIN, BUILDINGS DRAWN IN THIS PLAN MAY VARY IN HEIGHT. UNITS SHOWN AS 1- OR 2-STORY MAY BE ONE OR TWO STORY UNITS WITH 1- OR 2-CAR GARAGES, BUT THE LOCATIONS AND BUILDING ENVELOPES SHALL REMAIN THE SAME ONCE APPROVED.

AREA TABULATION

BUILDING COVERAGE	330,332 SF	15.8%
IMPERVIOUS SURFACES	306,033 SF	14.7%
OPENSPACE/GREENSPACE UPLAND	630,846 SF	30.3%
EXISTING WETLAND & MITIGATION	647,221 SF	31.1%
EXISTING PONDS	169,692 SF	8.1%
TOTAL (47.84 Ac.)	2,084,094 SF	100%

FAR 330,332 / 2,084,094 = 0.16

PARKING TABULATION

143 SINGLE FAMILY ATTACHED UNITS

PARKING REQUIRED:
143 UNITS x 2.25 SPACE PER UNIT = 322 SPACES REQUIRED

PARKING PROVIDED:

GARAGE SPACES	= 178 SPACES
TANDEM SPACES	= 178 SPACES
TOTAL PARKING	= 356 SPACES

24 MULTI FAMILY UNITS
(LODGE VILLAS)

PARKING REQUIRED:
24 UNITS x 2.25 SPACE PER UNIT = 54 SPACES REQUIRED (x 0.02 = 2 HANDICAP REQUIRED)

PARKING PROVIDED:

STANDARD SPACES	= 125 SPACES
HANDICAP SPACES	= 4 SPACES
TOTAL PARKING	= 129 SPACES

*** PARKING NOTE:**
DRIVEWAYS, GARAGES AND PARKING SHOWN ARE REPRESENTATIVE OF THE ANTICIPATED CONSTRUCTION, BUT LOCATIONS AND NUMBER OF 2-CAR DRIVEWAYS & GARAGES MAY VARY. REGARDLESS OF FINAL PRODUCT MIX, AT NO TIME SHALL THE NUMBER OF PARKING SPACES FALL BELOW THAT REQUIRED BY PASCO COUNTY FOR BOTH RESIDENTS AND GUESTS.

Notes:
1. The original MPUD Plan was approved on October 24, 1973, with last MPUD amendment GM 99-375.

DATE	DESCRIPTION	BY
06/12/2020	12. HIDE LOT LINES PER PASCO COUNTY	JS
03/24/2020	11. REMOVE 12 UNITS PER DEVELOPER	JS
12/08/2017	10. UPDATES PER PASCO COUNTY	JS
10/26/2017	9. UPDATES PER DEVELOPER REDESIGN	JS
9/27/2016	8. UPDATES PER SITE GRADING & METER ASSEMBLY UPDATE	JS
10/03/2016	7. UPDATES PER PASCO COUNTY PLAT	JS
9/22/2016	6. REDESIGN OF BUILDINGS #1 - #4	JS
9/11/2016	5. ADD/ADJUST EASEMENTS & LABELING	JS
8/2/2016	4. REVISED PER COUNTY COMMENTS	JS
7/26/2016	3. ADD UPLAND BUFFER SIGNS PER SWFWMD COMMENTS, UPDATE MODEL HOME DESIGNATIONS PER PASCO CO.	
5/20/2016	2. REVISED PER COUNTY COMMENTS AND ARCHITECT/DEVELOPER SITE UPDATES	JS
3/11/2016	1. REVISED PER COUNTY COMMENTS AND OWNER SITE UPDATES	JS

Engineering Business Certificate of Authorization No.: 26548

Fuxan Engineering, Inc.
15018 Maurine Cove Ln.
Odessa, Florida 33556
Phone: 813-244-6194

DATE:
DAVID G. FUXAN P.E. NO. 33133
FLORIDA PROFESSIONAL ENGINEER

PRELIMINARY DEVELOPMENT PLAN

JOB NO.	2015-MP-01
DESIGN	FUXAN
DRAWN	SOMERVILLE
DATE	10-20-2017
FILE	3 PDP

ANAND VIHAR
2017 Redesign

PREPARED FOR: Anand Vihar, LLC

Elevations based on National Geodetic Vertical Datum 1929 (NGVD 29) Conversion from NGVD 29 to NAVD 88 = -0.83 Feet

SHEET 3A OF 20 SHEETS

ANAND VIHAR

RES-3 MPUD

MEADOW POINTE PARCEL 14 UNIT 1
PB 36, PG 101–105

WCA I

PRESERVATION AREA "3B"
O.R. Book 5064, Page 1572

WETLAND CONSERVATION AREA

S.W.F.W.M.D. UPLAND PRESERVATION AREA "3B"
O.R. Book 5064, Page 1572

CLAY GULLY RES-3 MPUD

WCA I

WCA II

PARK

TRACT A

TRACT E
PARK

TRACT F

GANGA WAY

NARMADA WAY

SARASWATI WAY

YAMUNA WAY

GODAVARI WAY

ANAND VIHAR DRIVE

FOXFORD LANE

HADDINGTON ...

MANSFIELD BLVD.
80' R/W – COLLECTOR

EXISTING POND 1
DHW: 59.80
DLW: 58.30
DNW: 57.80

EXISTING POND 2
DHW: 59.80
DLW: 58.30
DNW: 57.80

EXISTING POND 3
DHW: 60.00
DLW: 58.50
DNW: 58.00

EXISTING POND 4
DHW: 61.55
DLW: 61.05
DNW: 60.05

EXISTING POND 14-1
DHW = 61.2
DLW = 59.7
DNW = 59.2

EXISTING WETLAND MITIGATION

WETLAND "53"
53
SH= 60.05
NP=

42J
SH=59.20
NP=58.45

25
SH=60.87
NP=60.32

15' DRAINAGE EASEMENT

10' SIDE YARD UTILITY EASEMENT (TYPICAL)

20' FRONT UTILITY EASEMENT (TYP.)

23.5' DRAINAGE EASEMENT

22.5' DRAINAGE EASEMENT

10' SIDE YARD UTILITY EASEMENT (TYPICAL)

15' UTILITY EASEMENT

20' TYPE 'D' BUFFER
EMERGENCY GATE SHALL INCLUDE SOS OR 3M OPTICOM EQUIPMENT

CLEAR SIGHT TRIANGLE PER PASCO COUNTY (TYP.)

INSTALL UPLAND BUFFER SIGN (TYP. OF 10)

INSTALL UPLAND BUFFER SIGNS (TYP. OF 10)

SINGLE FAMILY MODEL HOMES (TYPICAL – REF. HATCH) (SEE NOTE, THIS SHEET)

FLOOD ZONE "AE"
EL. 60.83 (NGVD29)
(60.0 NAVD88)
FLOOD ZONE "X"

FLOOD ZONE "AE"
EL. 60.93 (NGVD29)
(60.1 NAVD88)
FLOOD ZONE "X"

FLOOD ZONE "AE"
EL. 60.75 (NGVD29)
(59.9 NAVD88)
FLOOD ZONE "X"

FLOOD ZONE "AE"
EL. 60.73 (NGVD29)
(59.9 NAVD88)

FLOOD ZONE "AE"
EL. 61.73 (NGVD29)
(60.9 NAVD88)
FLOOD ZONE "X"

FLOOD ZONE "AE"
EL. 60.83 (NGVD29)
(60.0 NAVD88)

FLOOD ZONE "AE"
EL. 61.73 (NGVD29)
(60.9 NAVD88)

FLOOD ZONE "A"

FLOOD ZONE "X"

REVISIONS TO BUILDING DEPTH AND FRONT SETBACK THROUGHOUT

20'x9' PARKING SPACES (TYP.)

24'x10' PARALLEL PARKING SPACES

(4) 24'x10' PARALLEL PARKING SPACES

HC RAMP (TYP.)

TENNIS COURT

FLUSH CURB UNDER COVER

10,940 SF ONE-STORY CLUBHOUSE & AMENITY CENTER

REDUCED CLUBHOUSE FOOTPRINT

12-LODGE VILLAS (EXISTING 2-STORY)

24'x10' PARALLEL SPACE (TYP.)

20'X9' STANDARD SPACES (TYP.)

EX. 8" DCDVA/ 5" BULK METER W/ SINGLE BFP (2) 8" 45° BENDS, (2) 6" 45° BENDS

EX. 2' CONC. S/W

EX. 22' PAVEMENT W/ 12' LANES (2) 4' BIKE LANES

EX. 2' VALLEY GUTTER

20.0' LANDSCAPE WALL/ DRAINAGE EASEMENT

19' UTILITY EASEMENT EAST SIDE OF GODAVARI WAY

20' FRONT UTILITY EASEMENT (TYPICAL)

15' DRAINAGE EASEMENT

EROSION CONTROL (TYP.)

PUBLIC UTILITY EASEMENT

15' PRIVATE UTILITY EASEMENT

5' PRIVATE UTILITY EASEMENT

PRIVATE UTILITY EASEMENT

DRAINAGE EASEMENT (WIDTH VARIES)

20' DRAINAGE EASEMENT

DRAINAGE EASEMENT

EROSION CONTROL (TYP.)

HC RAMP (TYP.)

15' TO DESIGN HIGH

5.0' FLAT @10:1

10.0' @10:1

10.0' FLAT @10:1

5.0' FLAT @10:1

10.0' @10:1

5.0' FLAT @10:1

10.0' @10:1

5.0' FLAT @10:1

10.0'

SEE SHEET 6 FOR CONTINUATION

SEE SHEET 5 FOR CONTINUATION

SEE SHEET 6 FOR CONTINUATION

SEE SHEET 7 FOR CONTINUATION

EX. MH 1A

EX. 105 LF 36" RCP STORM @ 1.00%

EX. 6" SAN SVC W/ C.O. (TYP.)

EX. MH 2 TOP 61.45 NE INV 51.45 NW INV 51.45

EX. MH 1 TOP 61.66 SE INV 54.40 NE INV 54.40

EX. WATER SVC TO REMAIN (TYP.)

EX. 6" SAN SVC W/ C.O. (TYP.)

EX. 6" SAN SVC W/ C.O. TO REMAIN

EX. SAN C.O. RIM 55.80

EX. 6" SAN SVC W/ C.O. (TYP.)

EX. GREASE TRAP INV 55.90

CLUBHOUSE FF EL = 63.00

FF 63.0

FF 63.1

FF 62.4

FF 62.7

FF 62.9

FF 63.1

FF 63.2

FLOOD ZONE "X"

FLOOD ZONE "AE" EL.60.83 (NGVD29) (60.0 NAVD88)

EX. 30" RCP

EX. 24" WATER SVC. (TYP.)

EX. 6" SAN SVC W/ C.O. (TYP.)

EX. PLUGGED 4" FIRE

EX. FIRE HYDRANT TO REMAIN (TYP.)

EX. 6" SAN SVC W/ C.O. (TYP.)

93 LF EX. 18" SM

215 LF EX. 8" SM

EX. 18" RCP TO REMAIN

EX. 24" RCP TO REMAIN

EX. 24" WATER SVC (TYP.)

EX. 6" SAN SERVICE WITH CLEANOUT (TYP.)

SAW-CUT & REMOVE ±25 LF EX. S/W

EX. FIRE HYDRANT TO REMAIN

EX. 6" SAN SVC W/ C.O. (TYP.)

EX. 24" WATER SVC. (TYP.)

EX. 6" SAN SVC W/ C.O. (TYP.)

EX. 24" WATER SVC (TYP.)

EX. 6" SAN SERVICE WITH CLEANOUT (TYP.)

EX. PLUGGED 8" FIRE

EX. 6" SAN SERVICE WITH CLEANOUT (TYP.)

EX. 24" WATER SVC (TYP.)

EXISTING LIGHT POLE (TYP.)

EX. 6" SAN SVC W/ C.O. (TYP.)

EX. 6" SAN SVC W/ C.O. (TYP.)

EX. 6" SAN SVC W/ C.O.

WETLAND "42J"

42J
SH=59.20
NP=58.45

WCA I

WETLAND "25"

25
SH=60.87
NP=60.32

WCA I

SEE SHEET 6 FOR CONTINUATION

SEE SHEET 7 FOR CONTINUATION

SEE SHEET 7 FOR CONTINUATION

SEE SHEET 4 FOR CONTINUATION

SWFWMD WETLAND LINE (TYP.)

15' WETLAND BUFFER (MIN.)

15.00' (MIN.)

FLOOD ZONE "AE" EL.60.73 (NGVD29) (59.9 NAVD88)

FLOOD ZONE "X"

FLOOD ZONE "AE" EL.60.93 (NGVD29) (60.1 NAVD88)

FLOOD ZONE "AE" EL.61.73 (NGVD29) (60.9 NAVD88)

EX. CONCRETE TRANSFORMER PAD

EX. SEWAGE PUMP STATION

ASPHALT DRIVE

EX. R1-1 30" x 30" W/ B3 STREET NAME SIGNS

EX. 12" ROOF DRAIN TO REMAIN

EX. SAN C.O. TO REMAIN

EX. WATER SVC TO REMAIN

EXISTING LIGHT POLE (TYP.)

EX. SAN CLEANOUTS ±15FT FROM EOP (TYP. BOBS #39-45)

EX. WATER SVC ±15FT FROM EOP (TYP. BOBS #39-45)

EX. 18" RCP TO REMAIN

EX. F.H. TO REMAIN

CUT & RELOCATE EX. WATER SVC ±15FT FROM EOP

EX. SAN CLEANOUT ±15FT FROM EOP

EXISTING MH 9-2 TOP 60.50 SW INV 51.74 E INV 51.71

EX. 8" PVC YARD DRAIN

EX. 6" SAN SVC W/ C.O. (TYP)

EX. MH 1-A TOP 61.60 SW INV 54.43 NW INV 54.43

EX. 36" RCP 1.00% 105 LF STORM MH 1A

EX. MH 8-4 TOP 60.56 SE INV 53.71 SW INV 53.66 NW INV 53.63

EX. 6" SAN SVC W/ C.O. (TYP)

EX. MH 7-1 TOP 61.60 SE INV 54.43 NE INV 54.43

EX. 6" SAN SVC W/ C.O. (TYP)

EX. 6" SAN C.O.

EX. 6" UNDERDRAIN

EX. 215 LF EX. 8" SDR

EX. FIRE HYDRANT (TYP)

EX. 6" WATER SVC TO REMAIN (TYP.)

EX. MH 7-2 TOP 61.60 SW INV 54.43 NE INV 54.43

EX. 6" SAN C.O.

EX. TRIHEADWALL

EX. TRAP INV 55.80

CLUBHOUSE FF EL = 65.60

(WM) 4" G.V. (FIRE) & GAS SEE ARCHITECTURAL PLANS FOR FDC AND POSITION INDICATOR VALVE

EX. 6" SAN C.O. TO REMAIN

EX. 6" SAN SVC W/ C.O. (TYP.)

EX. 6" SAN SVC W/ C.O. (TYP.)

EX. 6" SAN SVC W/ C.O. (TYP.)

WETLAND "42J"

42J
SH=59.20
NP=58.45

WCA I

S.W.F.W.M.D. UPLAND PRESERVATION AREA "3B"
O.R. Book 5064, Page 1572

UPLAND PRESERVATION EASEMENT

SWFWMD WETLAND LINE (TYP.)

15' WETLAND BUFFER (MIN.)

15.00' (MIN.)

15.00'

25.00'

FLOOD ZONE "AE" EL.60.93 (NGVD29) (60.1 NAVD88)

FLOOD ZONE "X"

FLOOD ZONE "AE" EL.60.73 (NGVD29) (59.9 NAVD88)

FLOOD ZONE "AE" EL.60.83 (NGVD29) (60.0 NAVD88)

EX. R1-1 30" x 30" W/ D3 STREET NAME SIGNS

(2) EX. CASE II 18" x 18" RED REFLECTORS PER FDOT INDEX 17349

EROSION CONTROL (TYP.)

EXISTING LIGHT POLE (TYP.)

EX. F.H. TO REMAIN

EX. WATER SVC TO REMAIN

EX. SAN C.O. TO REMAIN

EX. 12" ROOF DRAIN TO REMAIN

EX. 18" RCP TO REMAIN

EX. FIRE HYDRANT

CLUBHOUSE FF EL = 63.00

(WM) 4" GV (FIRE) 8" GV PER ARCHITECTURAL PLANS SEE ARCHITECTURAL PLANS FOR FDC AND POSITION INDICATOR VALVE

WCA I

CONSERVATION AREA

JPLAND AREA "3B"

O.R. Book 5064, Page 1572

SEE SHEET 7 FOR CONTINUATION

SEE SHEET 5 FOR CONTINUATION

SEE SHEET 4 FOR CONTINUATION

N

80 40 0 40 80

SCALE: 1" = 40'

LEGEND

EXISTING (REMAIN)	EXISTING (REMOVE)	
		STORM DRAINAGE STRUCTURE
(8)	(8)	DRAINAGE STRUCTURE NUMBER*
CO, ☆	CO, ☆	EX. UTILITY STRUCTURES
		EX. TRAFFIC SIGNAGE
+15.00		PRE-DEVELOPMENT EX. GRADE
52.00		EXISTING DEVELOPMENT GRADE
		STAKED EROSION CONTROL
		SWFWMD WETLAND LINE
		25' OFFSET FROM SWFWMD WETLAND LINE SHOWN FOR INFORMATIONAL PURPOSES
		EX. ASPHALT TO BE SAW-CUT & REMOVED (±149,000 SF)**
		EX. ASPHALT TO REMAIN (±142,473 SF)
		2014 FEMA FLOOD BOUNDARY

NOTES:
1. * Existing drainage structures per approved Heidt & Associates plans dated January 12, 2005 (Project No. PDH MP 008)

2. ** Where marked for removal, all existing curb and asphalt shall be removed entirely, including base and stabilization layers, and backfilled with material suitable for sod & landscape plantings, except where base & stabilization can be reused for new drives and building pads.

3. Any disturbed right-of-way shall be returned to predevelopment or better condition.

4. *** Utilities removal note: Utilities marked for removal shall be removed in their entirety unless they lie beneath an existing roadway that is to remain in place. Such utilities shall be cut as near as possible to the edge of pavement and capped/plugged at both ends.

Project lies within Flood Zones "X & AE" as shown on FIRM Panel No. 12101C0437F, dated September 26, 2014

NO WETLAND IMPACTS OR MITIGATION ARE PROPOSED IN THIS PROJECT

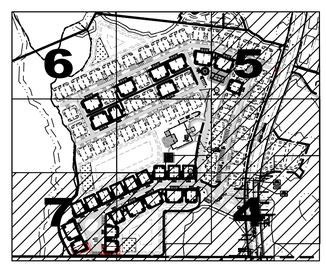

KEY MAP

CALL 48 HOURS BEFORE YOU DIG
IT'S THE LAW! DIAL 811
Know what's below. Call before you dig.
SUNSHINE STATE ONE CALL OF FLORIDA, INC.

DATE	DESCRIPTION	BY
03/24/2020	3. REVISED PER MINOR MODIFICATION & TO REFLECT COMPLETED WORK TO DATE	JS
10/25/2017	2. REVISED PER DEVELOPER REDESIGN	JS
3/15/2016	1. REVISED PER COUNTY COMMENTS AND OWNER SITE UPDATES	JS

REVISIONS

Engineering Business Certificate of Authorization No.: 26548
Fuxan Engineering, Inc.
No. 33133
15018 Maurine Cove Ln.
Odessa, Florida 33556
Phone: 813-244-6194
STATE OF FLORIDA
DAVID G. FUXAN REGISTERED PROFESSIONAL ENGINEER
DATE:
DAVID G. FUXAN P.E. NO. 33133
FLORIDA PROFESSIONAL ENGINEER

DEMOLITION PLAN (3)

JOB NO. 2015-MP-01	ANAND VIHAR 2017 Redesign
DESIGN FUXAN	
DRAWN SOMERVILLE	PREPARED FOR: Anand Vihar, LLC
DATE 10-20-2017	Elevations based on National Geodetic Vertical Datum 1929 (NGVD 29) Conversion from NGVD 29 to NAVD 88 = -0.83 Feet
FILE DEMO	SHEET 6 OF 20 SHEETS

SEE SHEET 6 FOR CONTINUATION

SEE SHEET 5 FOR CONTINUATION

SEE SHEET 4 FOR CONTINUATION

WETLAND CONSERVATION AREA

S.W.F.W.M.D. UPLAND PRESERVATION AREA "3B"
O.R. Book 5064, Page 1572

WCA I

WCA II

WETLAND "5"
53
SH= 60.05
NP=

(2) EX. CASE II 18" x 18" RED REFLECTORS PER FDOT INDEX 17349

EX. R1-1 30" x 30" W/ D3 STREET NAME SIGNS

EROSION CONTROL (TYP.)

25.00' (TYP.)

SWFWMD WETLAND LINE

25' WETLAND BUFFER

UPLAND PRESERVATION EASEMENT

FLOOD ZONE "AE" EL.60.83 (NGVD29) (60.0 NAVD88)

FLOOD ZONE "X"

12" RCP - DRAIN TO BE REMOVED

CLUBHOUSE FF EL = 63.00

EX. FIRE HYDRANT

EX. TRASH COMPACTOR

EX. PLUGGED 8" FIRE

EX. 6" SAN SERVICE WITH CLEANOUT (TYP.)

EX. 24" WATER SVC. (TYP.)

EX. 6" SAN SVC W/ C.O. (TYP.)

EX. 6" SAN SVC W/ C.O.

EX. PLUGGED 4" FIRE

EX. FIRE HYDRANT TO REMAIN (TYP.)

EX. 6" SAN SVC W/ C.O. (TYP.)

EX. 24" WATER SVC. (TYP.)

EX. 6" SAN SVC W/ C.O. (TYP.)

EX. 6" SAN SERVICE WITH CLEANOUT (TYP.)

EX. 24" WATER SVC (TYP.)

EX. 6" SAN SERVICE WITH CLEANOUT (TYP.)

SAW-CUT & REMOVE ±25 LF EX. S/W

EX. FIRE HYDRANT TO REMAIN

EX. LIGHT POLE (TYP.)

EX. 24" WATER SVC. (TYP.)

EX. 6" SAN SERVICE WITH CLEANOUT (TYP.)

EX. 6" SAN SVC W/ C.O. (TYP.)

EX. 24" WATER SVC (TYP.)

EX. R1-1 30" x 30" W/ D3 STREET NAME SIGNS

EX. R1-2

EX. R4-7

EX. OM1-1

EROSION CONTROL (TYP.)

EX. 24" RCP TO REMAIN

EX. 30" RCP

EX. 18" RCP TO REMAIN

EX. 12" RCP TO REMAIN

EX. 36" RCP

EX. 42" RCP

EX. 24" RCP TO REMAIN

EX. 12" SVC UNDER DRAIN

EX. 6" SAN SVC W/ C.O.

EX. 8" SAN SVC W/ C.O.

EX. 6" SAN SVC W/ C.O. (TYP.)

EX. WATER SVC TO REMAIN (TYP.)

EX. WATER SVC TO REMAIN BDGS #9, 32

EX. 6" SAN SVC W/ C.O. (TYP.) REMAIN BDGS #9, 32

EX. WATER SVC TO REMAIN BDGS #20-#31

EX. FIRE HYDRANT (TYP.)

EX. 6" SAN SVC W/ C.O.

EX. WATER SVC TO REMAIN (TYP.)

EX. 6" SAN SVC W/ C.O. (TYP.)

EX. MH 1A TOP 61.60 NE INV 54.45 NW INV 54.45 SE INV 54.45

EX. MH 2 TOP 61.40 NE INV 55.45 NW INV 55.45

EX. 6" SAN C.O. INV 55.80

EX. 6" SAN SVC W/ C.O. (TYP.)

EX. 6" SAN SVC W/ C.O.

EX. 6" SAN SVC W/ C.O. (TYP.)

EX. 6" SAN SVC W/ C.O. (TYP.)

EX. 6" SAN SVC W/ C.O. (TYP.)

SEE SHEET 10 FOR CONTINUATION

SEE SHEET 9 FOR CONTINUATION

SEE SHEET 10 FOR CONTINUATION

SEE SHEET 11 FOR CONTINUATION

YAMUNA WAY

ANAND VIHAR DRIVE

NARMADA WAY

GODAVARI WAY

MANSFIELD BLVD. 80' R/W – COLLECTOR

MANSFIELD BLVD. 80' R/W – COLLECTOR

PARK

#1A #1B #2A #2B #6A #6B #6C #7A #7B #7C #8 #9 #10 #16A #16B #16C #17A #17B #17C #48 #49 #50 #51

EXISTING POND 2
DHW: 59.80
DLW: 58.30
DNW: 57.80

EXISTING POND 3
DHW: 60.00
DLW: 58.50
DNW: 58.00

EXISTING POND 4
DHW: 61.55
DLW: 61.05
DNW: 60.05

EXISTING POND
DHW = 61.5
DLW = 60.3
DNW = 60.0

Pickleball Courts

EXISTING WETLAND MITIGATION

MITIGATION AREA
M-26
0.55 AC±
(HERBACEOUS)

WETLAND "53"
53
SH=60.05
NP=

WCA II

FLOOD ZONE "AE"
EL.60.83 (NGVD29)
(60.0 NAVD88)

FLOOD ZONE "X"

FLOOD ZONE "AE"
EL.61.73 (NGVD29)
(60.9 NAVD88)

FLUSH CURB UNDER COVER

HC RAMP (TYP.)

PROPOSED 5' CONC. S/W (TYP.)

5' CONC. S/W (TYP.)

EROSION CONTROL (TYP.)

YARD DRAIN TOP EL 60.80 W/±3LF 8" PVC CONNECTION TO EX. YARD DRAIN

TOP EL 60.80 W/±3LF 8" PVC CONNECTION TO EX. YARD DRAIN

YARD DRAIN TOP EL 61.20 W/±3LF 8" PVC CONNECTION TO EX. YARD DRAIN

YARD DRAIN TOP EL 61.20 W/±3LF 8" PVC CONNECTION TO EX. YARD DRAIN

20' TYPE 'D' BUFFER

15' WETLAND BUFFER

SWFWMD WETLAND LINE

SIDEWALK FLUSH WITH PAVEMENT

EX. 18" RCP TO REMAIN

EX. 24" RCP TO REMAIN

EX. 30" RCP

EX. 36" RCP STORM @ 1.00%

EX. MH 1A

UNDERDRAIN

UDCO

LITTORAL ZONE

PASCO COUNTY

HILLSBOROUGH COUNTY

32 33

PROPOSED DRAINAGE STRUCTURE DATA

1	MITERED END SECTION INV.=53.80
1A	MANHOLE TOP=60.80 INV.=54.90

NOTE: INSTALL CHAINS ON ON-SITE INLET GRATES

N

80 40 0 40 80

SCALE: 1" = 40'

EXISTING DRAINAGE STRUCTURE DATA

(ADDITIONAL EXISTING STRUCTURES PER APPROVED PLANS BY HEIDT & ASSOCIATES, REF. JOB NO: PDH MP 008) (SEE EXISTING STRUCTURE DATA SHEET)

2	TYPE "C" GTI W/ 4'x5' BOTTOM TOP=60.30 INV.=55.00
3	MITERED END SECTION INV.=53.80
4	MANHOLE TOP=61.60 INV.=55.40
5	MANHOLE TOP=61.80 INV.=55.00
6	MANHOLE TOP=61.50 INV.=54.50
7	MITERED END SECTION INV.=53.80
YD 1	YARD DRAIN INLET TOP=61.50 INV.=60.00
YD 2	YARD/ROOF DRAIN MH TOP=61.20 INV.=58.00
YD 3	YARD/ROOF DRAIN MH TOP=61.50 INV.=59.50
YD 4	YARD/ROOF DRAIN MH TOP=61.50 INV.=58.50
YD 5	YARD DRAIN INLET TOP=61.80 INV.=57.70
YD 6	YARD/ROOF DRAIN MH TOP=61.50 INV.=57.00
YD 7	YARD DRAIN INLET TOP=60.30 INV.=58.30
YD 7A	YARD DRAIN INLET TOP=61.30 INV.=59.00
YD 7B	YARD DRAIN INLET TOP=61.80 INV.=59.00
YD 8	YARD DRAIN INLET TOP=61.50 INV.=58.50
YD 9	YARD/ROOF DRAIN MH TOP=60.50 INV.=58.00
YD 10	YARD DRAIN INLET TOP=61.70 INV.=57.70

LEGEND

EXISTING	PROPOSED	
		STORM DRAINAGE STRUCTURE
(8)		EXISTING STRUCTURE NO.*
	2	PROPOSED STRUCTURE NO.
+15.00		PRE-DEVELOPMENT EX. GRADE
+50.00		EXISTING DEVELOPMENT GRADE
	52.00	PROPOSED GRADE
		DIRECTION OF SLOPE
		STAKED EROSION CONTROL
		SWFWMD WETLAND LINE
		25' OFFSET FROM SWFWMD WETLAND LINE SHOWN FOR INFORMATIONAL PURPOSES
		NEW ASPHALT PAVEMENT
		NEW CONCRETE
		PARK AREA ±260,161 S.F.
		2014 FEMA FLOOD BOUNDARY

NOTES:
1. All roof runoff shall be directed to parking areas or roof drain systems or be allowed to sheet flow into immediately adjacent on-site storm ponds.

2. Roof drain system to be 12" diameter ADS N-12 or equal smooth interior wall. Min. 0.5% slope.

3. Spot elevations shown hereon are at asphalt surface and/or finished ground surface elevation.

* NOTE: Additional Existing drainage structures per approved Heidt & Associates plans dated January 12, 2005 (Project No. PDH MP 008). See "EXISTING STRUCTURE DATA SHEET" (ESTR 1 of 1) for details.

Project lies within Flood Zones "X & AE" as shown on FIRM Panel No. 12101C0437F, dated September 26, 2014

NO WETLAND IMPACTS OR MITIGATION ARE PROPOSED IN THIS PROJECT

MEADOW POINTE
PARCEL 16 UNIT 3B
PB 47, PG 61–70

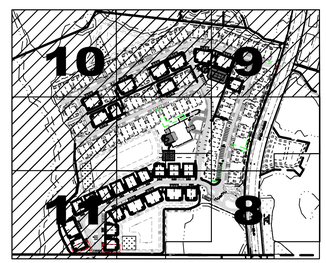

KEY MAP

DATE	DESCRIPTION	BY
03/24/2020	4. REVISED PER MINOR MODIFICATION & TO REFLECT COMPLETED WORK TO DATE	JS
12/08/2017	3. REDUCED CLUBHOUSE FOOTPRINT	JS
10/25/2017	2. DEVELOPER REDESIGN	JS
3/15/2016	1. REVISED PER COUNTY COMMENTS AND OWNER SITE UPDATES	JS

REVISIONS

Engineering Business Certificate of Authorization No.: 26548

Fuxan Engineering, Inc.
15018 Maurine Cove Ln.
Odessa, Florida 33556
Phone: 813-244-6194

DAVID G. FUXAN P.E. NO. 33133
FLORIDA PROFESSIONAL ENGINEER

DATE:

GRADING & DRAINAGE PLAN (1)

JOB NO. 2015-MP-01

ANAND VIHAR
2017 Redesign

DESIGN FUXAN

DRAWN SOMERVILLE

PREPARED FOR: Anand Vihar, LLC

DATE 10-18-2017

Elevations based on National Geodetic Vertical Datum 1929 (NGVD 29) Conversion from NGVD 29 to NAVD 88 = -0.83 Feet

FILE GDP

SHEET 8 OF 20 SHEETS

RES-3 MPUD

WETLAND "42J" 42J SH=59.20 NP=58.45

WCA I

MEADOW POINTE PARCEL 14 UNIT 1 PB 36, PG 101–105

WCA I

WETLAND "25" 25 SH=60.87 NP=60.32

MEADOW POINTE PARCEL 16 UNIT 3A PB 45, PG 127–134

HADDINGTON WAY

GANGA WAY

NARMADA WAY

YAMUNA WAY

GODAVARI WAY

FOXFORD LANE

MANSFIELD BLVD 80' R/W COLLECTOR

PARK

SEE SHEET 11 FOR CONTINUATION

SEE SHEET 8 FOR CONTINUATION

EXISTING POND 14 DHW = 61.2 DLW = 59.7 DNW = 59.2

EXISTING POND 2 DHW: 59.80 DLW: 58.30 DNW: 57.80

EXISTING POND DHW = 61.5 DLW = 60.3 DNW = 60.0

FLOOD ZONE "AE" EL.60.93 (NGVD29) (60.1 NAVD88)

FLOOD ZONE "X"

FLOOD ZONE "AE" EL 60.73 (NGVD29) (59.9 NAVD88)

FLOOD ZONE "AE" EL.61.73 (NGVD29) (60.9 NAVD88)

FLOOD ZONE "AE" EL.60.85 (NGVD29) (60.0 NAVD88)

FLOOD ZONE "AE" EL.61.73 (NGVD29) (60.9 NAVD88)

60.4 FLOOD ZONE "A"

SWFWMD WETLAND LINE (TYP.)

15' WETLAND BUFFER (MIN.)

15' TYPE 'B' BUFFER

20' TYPE 'D' BUFFER

EMERGENCY GATE SHALL INCLUDE SOS OR 3M OPTICOM EQUIPMENT

EX. CONCRETE TRANSFORMER PAD

EX. SEWAGE PUMP STATION TOP SLAB EL. 64.30

ASPHALT DRIVE

EXISTING LIGHT POLE (TYP.)

EX. LIGHT POLE (TYP.)

GAZEBO

TENNIS COURT

SIDEWALK FLUSH WITH PAVEMENT (TYPICAL)

20'x9' PARKING SPACES (TYP.)

PROPOSED 5' CONC. S/W (TYP.)

HC RAMP (TYP.)

FLUSH CURB UNDER COVER

Pickleball Courts

EXISTING TRANSFORMER (TYP.)

YARD DRAIN TOP EL 61.20 W/±3LF 8" PVC CONNECTION TO EX. YARD DRAIN

YARD DRAIN TOP EL 60.80 W/±3LF 8" PVC CONNECTION TO EX. YARD DRAIN

EROSION CONTROL (TYP.)

32' PAVEMENT W/ (2) 12' BIKE LANES

EX. 2' VALLEY GUTTER

EX. CONC. S/W

EX. 18" RCP

SWFWMD

#1 #2 #3 #4 #5 #6 #7A #7B #7C #8 #9 #10 #11 #12 #13 #14 #15 #16A #16B #16C #17A #17B #17C #22 #23 #24 #25 #26 #27 #28 #29 #37 #38 #39 #40 #41 #42 #43 #44 #45 #46 #47 #48 #49 #50

SCALE: 1" = 40'

80 40 0 40 80

N

LEGEND

EXISTING	PROPOSED	
----□----	——■——	STORM DRAINAGE STRUCTURE
(8)	2	EXISTING STRUCTURE NO.* / PROPOSED STRUCTURE NO.
+15.00		PRE–DEVELOPMENT EX. GRADE
~ 50.00		EXISTING DEVELOPMENT GRADE
	52.00	PROPOSED GRADE
		DIRECTION OF SLOPE
		STAKED EROSION CONTROL
		SWFWMD WETLAND LINE
		25' OFFSET FROM SWFWMD WETLAND LINE SHOWN FOR INFORMATIONAL PURPOSES
		NEW ASPHALT PAVEMENT
		NEW CONCRETE
		PARK AREA ±260,161 S.F.
		2014 FEMA FLOOD BOUNDARY

NOTES:
1. All roof runoff shall be directed to parking areas or roof drain systems or be allowed to sheet flow into immediately adjacent on–site storm ponds.

2. Roof drain system to be 12" diameter ADS N–12 or equal smooth interior wall. Min. 0.5% slope.

3. Spot elevations shown hereon are at asphalt surface and/or finished ground surface elevation.

* NOTE: Existing drainage structures per approved Heidt & Associates plans dated January 12, 2005 (Project No. PDH MP 008). See "EXISTING STRUCTURE DATA SHEET" (ESTR 1 of 1) for details.

Project lies within Flood Zones "X & AE" as shown on FIRM Panel No. 12101C0437F, dated September 26, 2014

NO WETLAND IMPACTS OR MITIGATION ARE PROPOSED IN THIS PROJECT

KEY MAP

DATE	REVISIONS	BY
03/24/2020	4. REVISED PER MINOR MODIFICATION & TO REFLECT COMPLETED WORK TO DATE	JS
12/08/2017	3. REDUCED CLUBHOUSE FOOTPRINT	JS
10/25/2017	2. DEVELOPER REDESIGN	JS
3/15/2016	1. REVISED PER COUNTY COMMENTS AND OWNER SITE UPDATES	JS

Engineering Business Certificate of Authorization No.: 26548

Fuxan Engineering, Inc.
15018 Maurine Cove Ln.
Odessa, Florida 33556
Phone: 813-244-6194

DAVID G. FUXAN No. 33133 STATE OF FLORIDA PROFESSIONAL ENGINEER

DATE:

DAVID G. FUXAN P.E. NO. 33133
FLORIDA PROFESSIONAL ENGINEER

GRADING & DRAINAGE PLAN (2)

JOB NO.	2015–MP–01
DESIGN	FUXAN
DRAWN	SOMERVILLE
DATE	10–18–2017
FILE	GDP

ANAND VIHAR
2017 Redesign

PREPARED FOR: Anand Vihar, LLC

Elevations based on National Geodetic Vertical Datum 1929 (NGVD 29) Conversion from NGVD 29 to NAVD 88 = -0.83 Feet

WETLAND "42J"

42J
SH=59.20
NP=58.45

WCA I

S.W.F.W.M.D. UPLAND PRESERVATION AREA "3B"
O.R. Book 5064, Page 1572

UPLAND PRESERVATION EASEMENT

15.00'

SWFWMD WETLAND LINE (TYP.)

15' WETLAND BUFFER (MIN.)

15.00' (MIN.)

25.00'

FLOOD ZONE "AE" EL.60.73 (NGVD29) (59.9 NAVD88)

FLOOD ZONE "X"

FLOOD ZONE "AE" EL.60.93 (NGVD29) (60.1 NAVD88)

FLOOD ZONE "AE" EL.60.83 (NGVD29) (60.0 NAVD88)

EX. R1-1 30" x 30" W/ D3 STREET NAME SIGNS

(2) EX. CASE II 18" x 18" RED REFLECTORS PER FDOT INDEX 17349

EROSION CONTROL (TYP.)

EXISTING LIGHT POLE (TYP.)

EX. F.H. TO REMAIN

EX. WATER SVC TO REMAIN

EX. SAN C.O. TO REMAIN

EXISTING MH 9-2 TOP 60.50 SW INV 51.74 E INV 51.71

(WM) 4" G.V. (FIRE) 8" G.V. SEE ARCHITECTURAL PLANS FOR FDC AND POSITION INDICATOR VALVE

CLUBHOUSE FF EL = 63.00

EX. TRANSFORMER

SEE SHEET 5 FOR CONTINUATION

SEE SHEET 4 FOR CONTINUATION

SEE SHEET 7 FOR CONTINUATION

WCA I

CONSERVATION AREA

UPLAND AREA "3B"

O.R. Book 5064, Page 1572

N

80 40 0 40 80

SCALE: 1" = 40'

LEGEND

EXISTING (REMAIN)	EXISTING (REMOVE)	
		STORM DRAINAGE STRUCTURE
(8)	(8)	DRAINAGE STRUCTURE NUMBER*
CO, ☆	CO, ☆	EX. UTILITY STRUCTURES
		EX. TRAFFIC SIGNAGE
+15.00		PRE-DEVELOPMENT EX. GRADE
52.00		EXISTING DEVELOPMENT GRADE
		STAKED EROSION CONTROL
		SWFWMD WETLAND LINE
		25' OFFSET FROM SWFWMD WETLAND LINE SHOWN FOR INFORMATIONAL PURPOSES
		EX. ASPHALT TO BE SAW-CUT & REMOVED (±149,000 SF)**
		EX. ASPHALT TO REMAIN (±142,473 SF)
		2014 FEMA FLOOD BOUNDARY

NOTES:
1. * Existing drainage structures per approved Heidt & Associates plans dated January 12, 2005 (Project No. PDH MP 008)

2. ** Where marked for removal, all existing curb and asphalt shall be removed entirely, including base and stabilization layers, and backfilled with material suitable for sod & landscape plantings, except where base & stabilization can be reused for new drives and building pads.

3. Any disturbed right-of-way shall be returned to predevelopment or better condition.

4. *** Utilities removal note: Utilities marked for removal shall be removed in their entirety unless they lie beneath an existing roadway that is to remain in place. Such utilities shall be cut as near as possible to the edge of pavement and capped/plugged at both ends.

Project lies within Flood Zones "X & AE" as shown on FIRM Panel No. 12101C0437F, dated September 26, 2014

NO WETLAND IMPACTS OR MITIGATION ARE PROPOSED IN THIS PROJECT

KEY MAP

CALL 48 HOURS BEFORE YOU DIG
IT'S THE LAW! DIAL 811
811 Know what's below. Call before you dig.
SUNSHINE STATE ONE CALL OF FLORIDA, INC.

DATE	DESCRIPTION	BY
03/24/2020	3. REVISED PER MINOR MODIFICATION & TO REFLECT COMPLETED WORK TO DATE	JS
10/25/2017	2. REVISED PER DEVELOPER REDESIGN	JS
3/15/2016	1. REVISED PER COUNTY COMMENTS AND OWNER SITE UPDATES	JS

REVISIONS

Engineering Business Certificate of Authorization No.: 26548
Fuxan Engineering, Inc.
No. 33133
15018 Maurine Cove Ln.
Odessa, Florida 33556
Phone: 813-244-6194
STATE OF FLORIDA
DAVID G. FUXAN P.E. NO. 33133
FLORIDA PROFESSIONAL ENGINEER
DATE:

DEMOLITION PLAN (3)

JOB NO. 2015-MP-01	ANAND VIHAR 2017 Redesign
DESIGN FUXAN	
DRAWN SOMERVILLE	PREPARED FOR: Anand Vihar, LLC
DATE 10-20-2017	Elevations based on National Geodetic Vertical Datum 1929 (NGVD 29) Conversion from NGVD 29 to NAVD 88 = -0.83 Feet
FILE DEMO	SHEET 6 OF 20 SHEETS

SEE SHEET 10 FOR CONTINUATION

SEE SHEET 9 FOR CONTINUATION

SEE SHEET 8 FOR CONTINUATION

CLAY GULLY
RES-3
MPUD

WETLAND CONSERVATION AREA

WCA
I

S.W.F.W.M.D. UPLAND
PRESERVATION AREA "3B"
O.R. Book 5064, Page 1572

PRESERVATION AREA
HIKING ALLOWED
PROHIBITED ACTIVITIES INCLUDE
MOWING, PRUNING, TRIMMING, AND
PLACEMENT OF PICNIC FACILITIES/
PARK AMENITIES

SARASWATI WAY

YAMUNA WAY

NARMADA WAY

ANAND VIHAR DRIVE

#16A #16B #16C #17A #17B #17C #18A #18B #18C #19 #20 #21 #32

#1A #1B #2A #2B #2C #3A #3B #4A #4B #5A #5B #5C #6A #6B #6C #7A #7B #7C

PROPOSED 5' CONC. S/W (TYP.)

HC RAMP (TYP.)

EROSION CONTROL (TYP.)

PROPOSED PARALLEL PARKING SPACE (TYP.)

FLUSH CURB UNDER COVER

FLOOD ZONE "AE" EL.60.83 (NGVD29) (60.0 NAVD88)

FLOOD ZONE "X"

EXISTING POND 2
DHW: 59.80
DLW: 58.30
DNW: 57.80

EXISTING POND 3
DHW: 60.00
DLW: 58.50
DNW: 58.00

Pickleball Courts

PARK

EX LIGHT POLE (TYP.)

24'x9' PARKING SPACE (TYP.)

SIDEWALK FLUSH WITH PAVEMENT

EX. TRASH COMPACTOR

EX. FAU GUARD HOUS

EXISTING LIG POLE (TYI

EXISTING WETLAND MITIGATION

WETLAND "5.
53
SH=60.05
NP=

WCA
II

PROPOSED 5' CONC. S/W (TYP.)

EROSION CONTROL (TYP.)

FF63.0 FF62.5 FF62.4 FF63.1 FF63.6 FF62.9

EX. 18" RCP TO REMAIN
EX. 24" RCP TO REMAIN
EX. 36" RCP TO REMAIN
EX. 30" RCP
EX. 12" RCP TO REMAIN
EX. 12" PVC ROOF DRAIN
EX. MH 1A
EX. 24" RCP TO REMAIN
EX. 18" RCP TO REMAIN
EX. 24" RCP TO REMAIN
EX. 18" RCP TO REMAIN
EX. 30" RCP
EX. 24" RCP TO REMAIN
EX. 18" RCP TO REMAIN
EX. 12" RCP TO REMAIN
EX. 18" RCP TO REMAIN
EX. 24

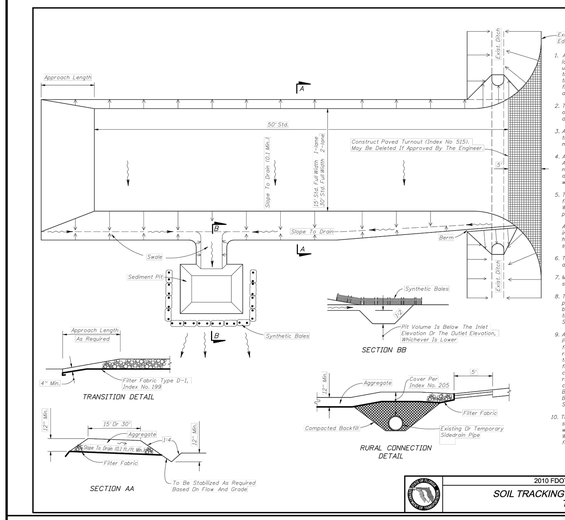

GENERAL NOTES

1. A Soil Tracking Prevention Device (STPD) shall be constructed at locations designated by the engineer for points of egress from unstabilized areas of the project to public roads where off-site tracking of mud could occur. Traffic from unstabilized areas of the construction entrance shall not bypass a STPD. Berriers, fogging, or other positive means shall be used as required to limit and direct vehicular egress across the STPD.
2. The Contractor may propose an alternative technique to minimize off-site tracking of sediment. The alternative must be reviewed and approved by the Engineer prior to its use.
3. Alimaterials spilled, dropped, or tracked onto public roads (including the STPD aggregate and construction mud) shall be removed daily, or more frequently if so directed by the Engineer.
4. Aggregates shall be as described in Section 901 excluding 901-2.3. Aggregates shall be FDOT size #1. If this size is not available, the next available smaller size aggregate may be substituted with the approval of the Engineer. Sizes containing excessive small aggregate will track off the project and are unsuitable.
5. The sediment pit should provide a retention volume of 3600 cubic feet/acre of surface area draining to the pit. When the STPD is isolated from other drainage areas, the following pit volumes will satisfy this requirement:
   - Type A = 50'x200 ft.³
   - Type B = 50'x200 ft.³

   As an option to the sediment pit, the width of the swale bottom can be increased to obtain the volume. When the sediment pit or swale volume has been reduced to one half, it shall be cleaned. When a swale is used, synthetic bales or silt fence shall be placed along the entire length.
6. The swale ditch draining the STPD shall have a 0.02ft minimum and a 1.0ft maximum grade along the STPD and to the sediment pit.
7. Mitered end sections are not required when the sideslopin pipe satisfies the clear zone requirements.
8. The STPD shall be maintained in a condition that will allow it to perform its function. To prevent off-site tracking, the STPD shall be rinsed (daily when in use) to move accumulated mud downward thru the stone. Additional stabilization of the vehicular route leading to the STPD may be required to limit the mud tracked.
9. A STPD shall be paid for under the contract unit price for Soil Tracking Prevention Device, EA. The unit price shall constitute full compensation for construction, maintenance, removal of the materials removed, and restoration of the area used for the STPD, including but not limited to excavation, grading, temporary pipe (including MES when required), filter fabric, aggregate, paved turnout (including asphalt and base construction), ditch stabilization, approach route stabilization, sediment removal and disposal, water, rinsing and cleaning of the STPD and cleaning of public roads, grassing and sod. Synthetic Bale or Bale Type Barrier shall be paid for under the contract unit price for Synthetic Bales, LF. Silt fence shall be paid for under the contract unit price for Staked Silt Fence, LF.
10. The nominal size of a standard STPD is 15' x 50' unless otherwise shown in the plans. If the volume of entering and existing vehicles warrant, a 30' width STPD may be used if approved by the Engineer. When a double width (30') STPD is used, the pay quantity shall be 2 for each location.

2010 FDOT Design Standards	Last Revision	Sheet No.
SOIL TRACKING PREVENTION DEVICE TYPE A	07/01/07	1 of 1
	Index No.	106

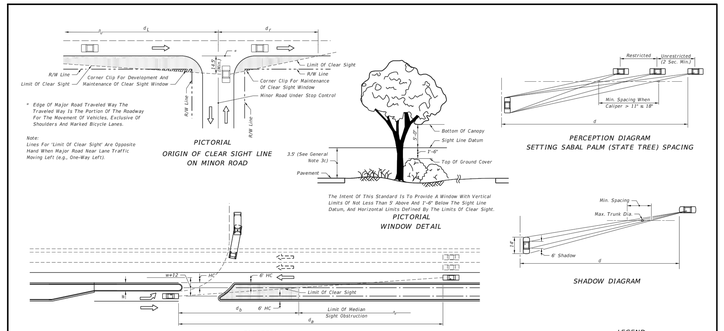

d_g (Feet)

Design Speed MPH	1 Lane Crossed			2 Lanes Crossed			3 Lanes Crossed		
	P	SU	Comb.	P	SU	Comb.	P	SU	Comb.
30	205	205	205	205	205	205	205	205	205
35	205	205	205	205	205	205	205	205	205
40	205	205	205	205	425	425	205	425	425
45	205	290	290	400	475	540	400	570	570

☆ See Note

☆ The d_g values in this table were established by the method referenced in Design Note 2, and are applicable to urban, predominantly curbed roadways with design speeds of 45 mph or less and meeting the restricted conditions defined in Index No. 700. For horizontal clearance (HC) of six feet (6'), the values for d_g may be determined by the equation $d_g = d_g$ (ft)x(HC)/25. For roadways with nonrestricted conditions, d_g and d_g should be based on the geometry for the left turn storage and on clear zone widths (See Index No. 700).

For wide medians where the turning vehicle can approach the through lanes at or near 90°, use d_g values from tables on sheets 5 or 6. (The clear sight line origin is assumed to be 14.5' from the edge of the near lane.)

CHANNELIZED DIRECTIONAL MEDIAN OPENINGS

LAST REVISION 07/01/14	DESCRIPTION:	2015 FDOT DESIGN STANDARDS	SIGHT DISTANCE AT INTERSECTIONS	INDEX NO. 546	SHEET NO. 2 of 6

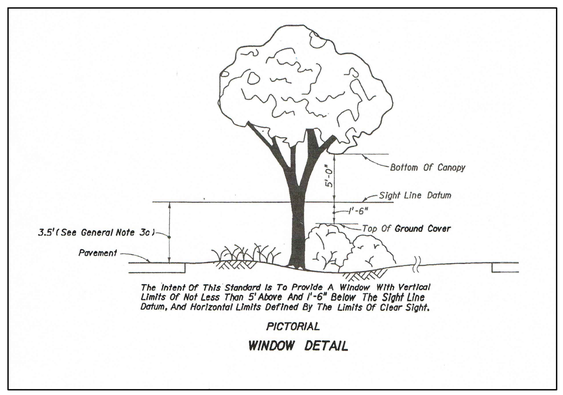

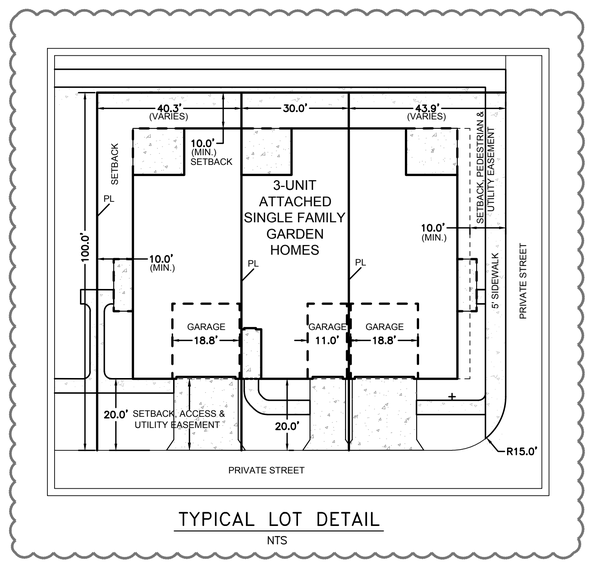

TYPICAL LOT DETAIL
NTS

PROPOSED PAVEMENT STRUCTURE
ALL LOCAL ROADS

Layer Coefficients		Thickness
0.44	Type SP-12.5 Asphalt Concrete Surface Course	1½"
0.15	Crushed Concrete Base Course (LBR 150)	6"
0.08	Stabilized Subgrade (LBR 40, 12" Min.)	12"

SN = (0.44) (1.50) + (0.15) (6) + (0.08) (12)

SN = 2.52

SN		SN_R
2.52	>	2.24

Use: 6" Crushed Concrete Base with 1-1/2" Type SP-12.5 A.C.S.C. and 12" Stabilized Subgrade (12" Min.)

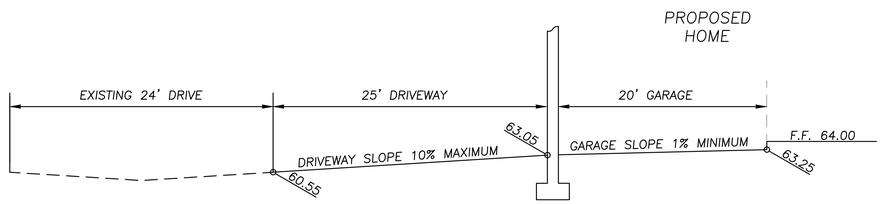

TYPICAL DRIVEWAY SECTION
NTS

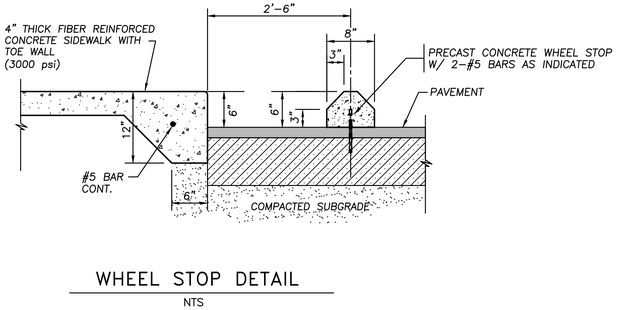

WHEEL STOP DETAIL
NTS

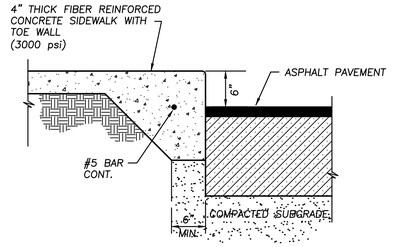

SIDEWALK/CURB DETAIL
NTS

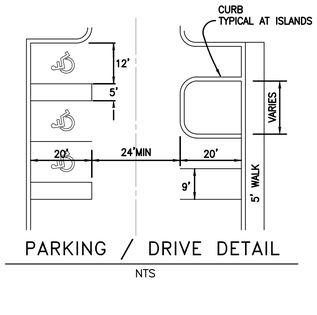

PARKING / DRIVE DETAIL
NTS

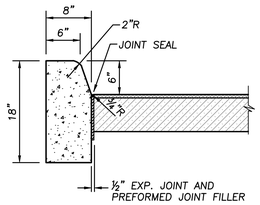

TYPE D CURB
NTS

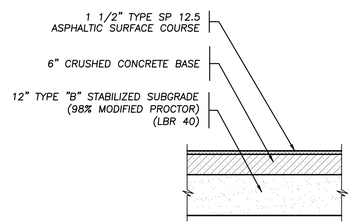

ASPHALT PAVEMENT SECTION
NTS

PAVEMENT CONSTRUCTION NOTES

1. Pavement wearing surface shall be asphaltic concrete of type and thickness shown in detail and shall meet current Depart-ment of Transportation Specifications.
2. Pavement base shall be soil-cement, as designated in plans, and shall be compacted to a minimum thickness as shown.
3. All Portland Cement Concrete shall have a minimum 28 day compressive strength of 3000 p.s.i.
4. Subgrade for soil-cement base construction shall be in accor-dance with D.O.T. Standard Specifications, latest edition.
5. Subgrade shall be be stabilized as necessary with a minimum LBR value of 20 which has been compacted to a minimum density of ninety-eight (98) percent , Modified Proctor. Subgrade shall be proof-rolled to grade, as directed by the Engineer and approved by the Engineer prior to placement of base course.
6. Soil-cement shall be with full blend borrow material using limerock, shell or other material as approved by the Engineer.
7. All curbs and gutters shall be placed on a foundation of Type "B" stabilized subgrade with a minimum LBR value of 40 (or a minimum FBV of 75) which has been compacted to a minimum density of ninety-eight (98) percent of the maximum density as determined by AASHTO T-180 for a minimum depth of twelve (12) inches.

ALTERNATIVE BASE MATERIAL
CRUSHED CONCRETE

Crushed concrete road base material should meet the following conditions:

1. Should be of uniform quality, free of all organics, steel rebar, asphalt debris, and any other deleterious material.
2. Should have a minimum Limerock Bearing Ratio (LBR) of 150, tested at a 300 foot frequency.
3. Single course lifts should not exceed 6-inches (loose).
4. Should conform to the gradation chart for graded aggregate base, FDOT Section 204, tested at a 500 foot frequency.
5. Should be compacted to a minimum of 98% of AASHTO T-180, tested at a 500 foot frequency.
6. Subgrade shall be be stabilized as necessary with a minimum LBR value of 40 which has been compacted to a minimum density of ninety-eight (98) percent , Modified Proctor. Subgrade shall be proof-rolled to grade, as directed by the Engineer and approved by the Engineer prior to placement of base course.

DATE	DESCRIPTION	BY
10/25/2017	2. DEVELOPER REDESIGN	JS
5/20/2016	1. REVISED PER COUNTY COMMENTS	JS

REVISIONS

Engineering Business Certificate of Authorization No.: 26548

Fuxan Engineering, Inc.
15018 Maurine Cove Ln.
Odessa, Florida 33556
Phone: 813-244-6194

DAVID G. FUXAN No. 33133 STATE OF FLORIDA PROFESSIONAL ENGINEER

DATE:
DAVID G. FUXAN P.E. NO. 33133
FLORIDA PROFESSIONAL ENGINEER

DRAINAGE DETAILS

JOB NO. 2015-MP-01	ANAND VIHAR 2017 Redesign
DESIGN FUXAN	
DRAWN SOMERVILLE	PREPARED FOR: Anand Vihar, LLC
DATE 12-18-2105	Elevations based on National Geodetic Vertical Datum 1929 (NGVD 29) Conversion from NGVD 29 to NAVD 88 = -0.83 Feet
FILE DD	SHEET 12 OF 20 SHEETS

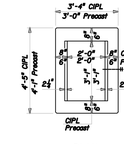

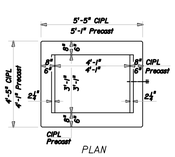

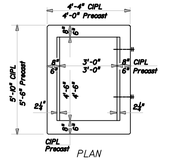

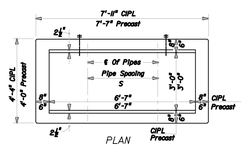

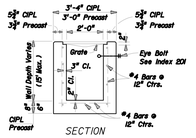

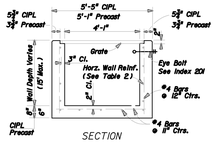

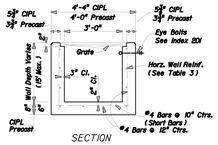

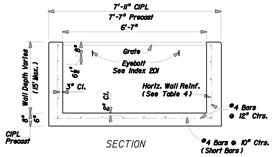

HORIZONTAL WALL REINFORCING SCHEDULES (TABLE 1)

WALL DEPTH	SCHEDULE	AREA (in^2/ft)	MAX. SPACING BARS	MAX. SPACING WWF
0'-15"	A12	0.20	12"	8"

TYPE C

Recommended Maximum Pipe Size:
2'-0" Wall - 18" Pipe
3'-1" Wall - 24" Pipe (18" where an 18" pipe enters a 2'-0" wall)

HORIZONTAL WALL REINFORCING SCHEDULES (TABLE 2)

WALL DEPTH	SCHEDULE	AREA (in^2/ft)	MAX. SPACING BARS	MAX. SPACING WWF
0'-6"	A12	0.20	12"	8"
0'-6"-10'	A6	0.20	6"	5"
10'-13"	A4	0.20	4"	3"
10'-15"	B5.5	0.24	5½"	5"

TYPE D

Recommended Maximum Pipe Size:
3'-1" Wall - 24" Pipe
4'-1" Wall - 36" Pipe

HORIZONTAL WALL REINFORCING SCHEDULES (TABLE 3)

WALL DEPTH	SCHEDULE	AREA (in^2/ft)	MAX. SPACING BARS	MAX. SPACING WWF
0'-5"	A12	0.20	12"	8"
0'-7.5"	A6	0.20	6"	5"
7.5'-10'	B5.5	0.24	5½"	5"
10'-15"	C8.5	0.37	8½"	6"

TYPE E

Recommended Maximum Pipe Size:
3'-0" Wall - 24" Pipe
4'-6" Wall - 36" Pipe

HORIZONTAL WALL REINFORCING SCHEDULES (TABLE 4)

WALL DEPTH	SCHEDULE	AREA (in^2/ft)	MAX. SPACING BARS	MAX. SPACING WWF
0'-5'	B5.5	0.24	5½"	5"
5'-7'	C6.5	0.37	6½"	6"
7'-15'	D4.5	0.53	4½"	4"

TYPE H (2 & 3-GRATE INLET)

Recommended Maximum Pipe Size:
3'-0" Wall - 24" Pipe
6'-7" Wall - 1-60" Pipe
Or 2-24" Pipe (S=3'-5")

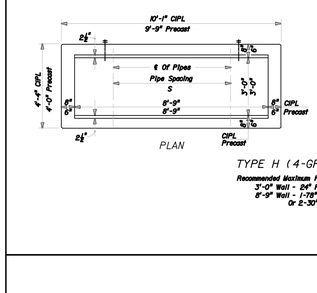

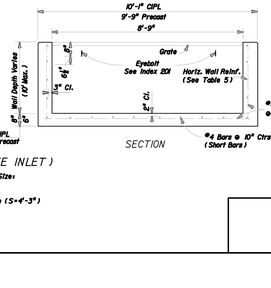

HORIZONTAL WALL REINFORCING SCHEDULES (TABLE 5)

WALL DEPTH	SCHEDULE	AREA (in^2/ft)	MAX. SPACING BARS	MAX. SPACING WWF
0'-5'	C5.5	0.37	3½"	3"
5'-10'	D4.5	0.53	4½"	4"

TYPE H (4-GRATE INLET)

Recommended Maximum Pipe Size:
3'-0" Wall - 24" Pipe
8'-9" Wall - 1-78" Pipe
Or 2-30" Pipe (S=4'-3")

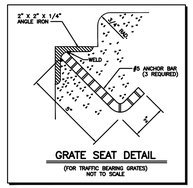

GENERAL NOTES

See Sheet 2 of 6.

DITCH BOTTOM INLET
TYPES C, D, E & H

Sheet No. 1 of 6

FDOT Std. 232

DIMENSIONS AND QUANTITIES

	D	X	A	B	C	E	F	G	H □	M Single Pipe	M Double Pipe	M Triple Pipe	M Quad. Pipe	N	5½" CONCRETE SLAB (CY) □ Single Pipe	5½" CONCRETE SLAB (CY) □ Double Pipe	5½" CONCRETE SLAB (CY) □ Triple Pipe	5½" CONCRETE SLAB (CY) □ Quad. Pipe	SODDING (SQ. YDS.) Single Pipe	SODDING (SQ. YDS.) Double Pipe	SODDING (SQ. YDS.) Triple Pipe	SODDING (SQ. YDS.) Quad. Pipe
1:2 Slope	15"	2'-7"	1.58'	2.28'	4.83'	2.06'	5'	1.22'	2.9'	4.63'	7.91'	9.79'	12.37'	1.5'	0.38	0.58	0.77	0.96	21	24	27	30
	18"	2'-10"	1.58'	2.74'	4.71'	2.58'	6'	1.41'	3.4'	4.98'	7.75'	10.58'	13.40'	1.5'	0.44	0.65	0.87	1.09	22	25	28	31
	24"	3'-10"	2.06'	3.85'	5.34'	3.58'	7'	1.73'	3.4'	5.50'	8.58'	12.33'	15.75'	1.25'	0.54	0.83	1.18	1.48	24	28	32	35
	30"	4'-3"	2.15'	4.95'	7.10'	4.58'	9'	2.07'	3.4'	6.08'	10.33'	14.58'	18.83'	1.25'	0.66	1.09	1.50	1.91	26	31	35	40
	36"	5'-1"	2.25'	5.95'	9.08'	6.33'	10'	2.24'	3.4'	6.67'	11.75'	16.83'	21.92'	1.5'	0.81	1.36	1.95	2.54	28	34	39	45
	42"	6'-0"	2.34'	7.29'	9.55'	6.56'	11'	2.45'	3.4'	7.25'	13.25'	19.25'	25.25'	1.38'	0.97	1.70	2.43	3.16	30	37	43	50
	48"	6'-9"	2.43'	8.33'	10.78'	7.56'	11'	2.65'	3.4'	7.83'	14.58'	21.33'	28.08'	1.42'	1.13	2.04	2.93	3.84	32	39	47	54
	54"	7'-7"	2.52'	9.44'	11.96'	8.56'	12'	2.86'	3.4'	8.46'	16.08'	23.75'	31.42'	1.46'	1.29	2.51	3.58	4.73	34	42	51	59
	60"	8'-6"	2.62'	10.56'	13.18'	9.56'	14'	3.07'	4.4'	9.00'	17.50'	26.00'	34.50'	1.50'	1.51	2.89	4.28	5.68	36	45	55	64
	66"	9'-4"	2.71'	11.68'	14.39'	10.56'	15'	3.28'	4.4'	9.58'	18.75'	27.92'	37.08'	1.54'	1.68	3.25	4.84	6.43	38	48	58	68
	72"	10'-0"	2.80'	12.80'	15.60'	11.56'	16'	3.30'	4.4'	10.16'	20.16'	30.16'	40.16'	1.58'	1.89	3.74	5.59	7.45	40	51	62	73
1:4 Slope	15"	2'-7"	2.27'	4.09'	6.36'	4.03'	9'	1.22'	4.0'	4.63'	7.91'	9.79'	12.37'	1.5'	0.57	0.87	1.15	1.44	23	26	29	32
	18"	2'-10"	2.27'	5.25'	7.48'	5.03'	10'	1.41'	4.0'	4.98'	7.75'	10.58'	13.40'	1.5'	0.66	0.98	1.31	1.65	25	28	31	35
	24"	3'-5"	2.53'	7.18' △	9.71'	7.03' △	11'	1.73'	4.0'	5.50'	8.58'	12.33'	15.75'	1.25'	0.85	1.30	1.75	2.20	28	32	36	40
	30"	4'-3"	2.71'	9.25'	11.85'	9.03'	13'	2.07'	4.0'	6.08'	10.33'	14.58'	18.83'	1.25'	1.10	1.74	2.39	3.05	31	36	41	46
	36"	5'-1"	2.90'	11.33' ◇	14.48'	11.03' ◇	15'	2.24'	4.0'	6.67'	11.75'	16.83'	21.92'	1.33'	1.32	2.23	3.08	3.96	34	40	46	52
	42"	6'-0"	3.05'	13.37'	16.42'	13.03'	17'	2.45'	4.0'	7.25'	13.25'	19.25'	25.25'	1.38'	1.58	2.76	3.91	5.09	38	44	51	58
	48"	6'-9"	3.22'	15.43'	18.65'	15.03'	19'	2.65'	4.0'	7.83'	14.58'	21.33'	28.08'	1.42'	1.85	3.30	4.73	6.17	41	48	56	63
	54"	7'-6"	3.39'	17.49'	20.88'	17.03'	21'	2.83'	4.0'	8.46'	16.08'	23.75'	31.42'	1.46'	2.14	3.95	5.77	7.58	44	52	61	69
	60"	8'-4"	3.56'	19.55'	23.12'	19.03'	23'	3.07'	4.0'	9.00'	17.50'	26.00'	34.50'	1.50'	2.45	4.66	6.87	9.07	47	56	66	75
	66"	9'-1"	3.73'	21.62'	25.35'	21.03'	25'	3.28'	4.0'	9.58'	18.75'	27.92'	37.08'	1.54'	2.88	5.54	8.18	10.84	49	59	69	80
	72"	10'-0"	3.91'	23.68'	27.59'	23.03'	27'	3.30'	4.0'	10.16'	20.16'	30.16'	40.16'	1.58'	3.54	6.61	9.67	13.13	52	63	74	85

See General Note No. 3.
See Sheet 5 Of 6 For 3" Slab Quantities

□ Values shown for estimating pipe quantities and are for information only.

△ 6.42' △ 6.25' Dimensions permitted to allow use of 8' standard pipe lengths.

◇ 10.47' ◇ 10.10' Dimensions permitted to allow use of 12' standard pipe lengths.

△◇ Concrete slab shall be deepened to form bridge across crown of pipe. See section below.

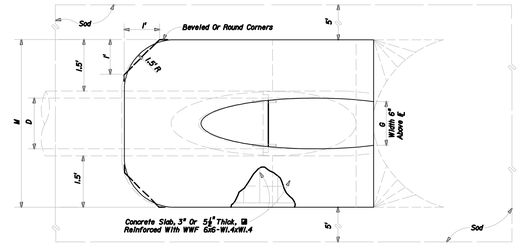

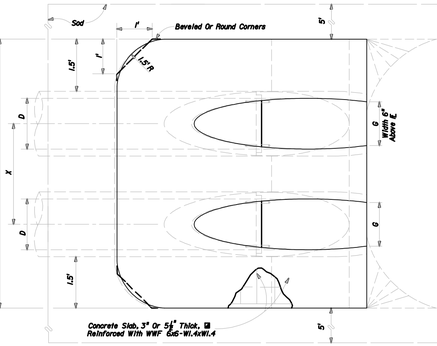

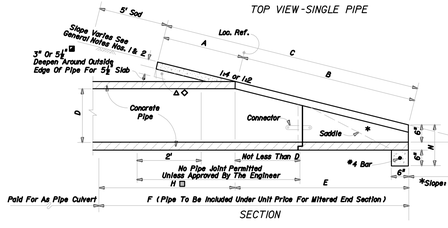

NOTE: See sheet 6 for details and notes.

CROSS DRAIN MITERED END SECTION
SINGLE AND MULTIPLE ROUND CONCRETE PIPE

Sheet No. 1 of 6

FDOT Std. 272

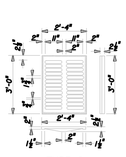

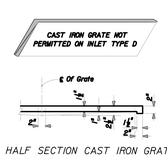

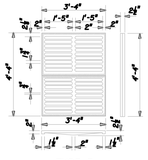

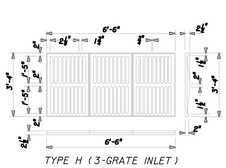

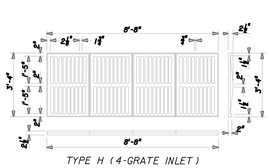

CAST IRON GRATES

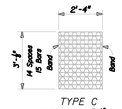

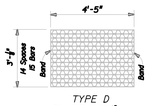

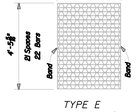

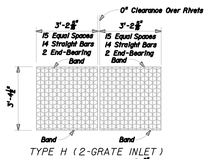

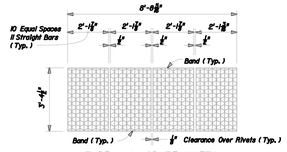

STEEL GRATES

NOTE: Steel Grates Are Required On Inlets With Traversable Slots And On Inlets where Bicycle Traffic Is Anticipated.

GENERAL NOTES

1. These inlets are suitable for bicycle traffic and are to be used in ditches, medians and other areas subject to infrequent traffic loadings but are not to be placed in areas subject to any heavy wheel loads. These inlets may be placed in areas subject to occasional pedestrian traffic such as landscaped areas and pavement areas where pedestrians can walk around the inlet.
2. Inlets subject to minimal debris should be constructed without slots. Where debris is a problem Inlets should be constructed with slots. Slotted inlets located within roadway clear zones and areas subject to bicycles and/or pedestrians shall have traversable slots. The traversable slot modification is not adaptable to Inlet Type H. Slots may be constructed at either or both ends as shown on plans.
3. Steel grates are to be used on all inlets where bicycle traffic is anticipated. Steel grates are to be used on all inlets with traversable slots. Either cast iron or steel grates may be used on inlets without slots where bicycle traffic is not anticipated. Either cast iron or steel grates may be used on all inlets with non-traversable slots. Subject to the selection described above, when Alternate G grate is specified in the plans, either the steel grate, hot dipped galvanized after fabrication, or the cast iron grate may be used, unless the plans stipulate the particular type.
4. Recommended maximum pipe sizes shown are for concrete pipe. Size for other types of pipe must be checked for fit.
5. All exposed corners and edges of concrete are to be chamfered ¾".
6. Concrete inlet pavement to be used on inlets without slots and inlets with non-traversable slots only when called for in the plans, but required on all traversable slot inlets. Cost to be included in contract unit price for inlets. Quantities shown are for information only.
7. Traversable slots constructed in existing inlets shall be paid for as inlets partial. For conversion work and method of payment see "TRAVERSABLE SLOT INLETS (PARTIAL) FOR EXISTING INLETS".
8. Sodding to be used on all inlets not located in paved areas and paid for under contract concrete inlet pavement unit price for Sodding, SY.
9. For supplementary details see Index No. 201.
10. All reinforcing Grade 60 bars with 2" min. cover unless otherwise noted. Bars to be cut or bent for 1½" clearance around pipe opening. Provide one additional #4 bar above and at each side of pipe opening.

DITCH BOTTOM INLET
TYPES C, D, E & H

Sheet No. 2 of 6

FDOT Std. 232

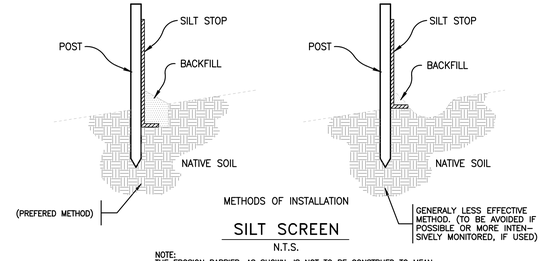

SILT SCREEN
N.T.S.

NOTE:
THE EROSION BARRIER, AS SHOWN, IS NOT TO BE CONSTRUED TO MEAN THAT IT IS ALL THAT MAY BE REQUIRED. THE CONTRACTOR IS TO TAKE WHATEVER MEASURES NECESSARY TO CONTROL EROSION THROUGHOUT THE PROJECT. EROSION CONTROL WILL BE INSTALLED PRIOR TO LAND CLEARING AND SHALL REMAIN IN PLACE UNTIL THE AREA IS STABILIZED. (SEE OTHER EROSION AND TURBIDITY NOTES ON THE GENERAL NOTES SHEET OF THIS PLAN.)

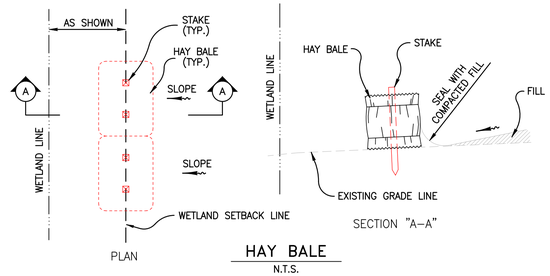

HAY BALE
N.T.S.

EROSION CONTROL DETAILS
EITHER METHOD OR A COMBINATION
OF BOTH IS ACCEPTABLE

DATE	DESCRIPTION	BY
	REVISIONS	

Engineering Business Certificate of Authorization No.: 26548

Fuxan Engineering, Inc.
15018 Maurine Cove Ln.
Odessa, Florida 33556
Phone: 813-244-6194

DAVID G. FUXAN P.E. NO. 33133
FLORIDA PROFESSIONAL ENGINEER

DATE:

DRAINAGE DETAILS

DESIGN FUXAN	
DATE 12-18-2015	Elevations based on National Geodetic Vertical Datum 1929 (NGVD 29) Conversion from NGVD 29 to NAVD 88 = -0.83 Feet
FILE DD	SHEET 13 OF 20 SHEETS

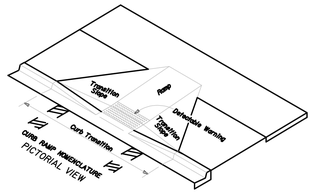

PICTORIAL VIEW

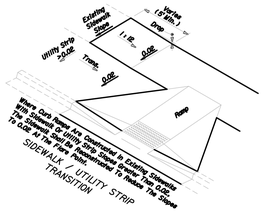

SIDEWALK - UTILITY STRIP TRANSITION

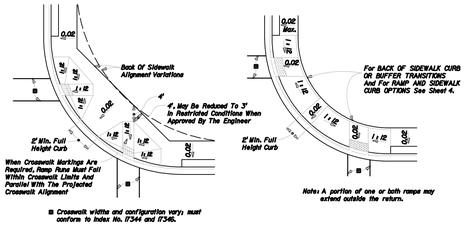


TYPICAL PLACEMENT OF PUBLIC SIDEWALK CURB RAMPS AT CURBED RETURNS

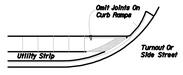

LINEAR SIDEWALK RAMPS

GENERAL NOTES

1. Public sidewalk curb ramps shall be constructed in the public right of way at locations that will provide continuous unobstructed pedestrian circulation paths to pedestrian areas, elements and facilities in the public right of way and to accessible pedestrian routes on adjacent sites. Curbed returns with sidewalks and flush shoulders are to have sidewalk curb ramps. Flush shoulders with sidewalks and flush medians have curbed returns. Parallel curb returns shall extend to the limit prescribed by Index No. 304. Undimensioned curb ramps, Ramps constructed at locations without sidewalks shall have a landing constructed at the top of each ramp, see Sheet 5.
2. The location and orientation of curb ramps shall be as shown in the plans.
3. Curb ramp running slopes of unrestrained sites shall not be steeper than 1:12 and cross slope shall be 0.02 or flatter. Transitions slopes shall not be steeper than 1:10.

   When altering existing pedestrian facilities where existing site development precludes the accommodation of a ramp slope of 1:12 and a running slope between 1:12 and 1:10 is permitted for a rise of 6" maximum and a running slope of between 1:10 and 1:8 is permitted for a rise of 3" maximum. Where compliance with the requirements for cross slope cannot be fully met, the minimum feasible cross slope shall be provided.

   Ramp running slope is not required to exceed 8' in length, except at sites where the plans specify a greater length.
4. If a curb ramp is located where pedestrians must walk across the ramp, then the walk shall have transition slopes to the ramp; the maximum slope of the transitions shall be 1:12. Ramps with curb returns may be used at locations where other improvements provide guidance away from that portion of curb perpendicular to the sidewalk. Improvements for guidance are not required at curb ramps for linear pedestrian traffic.
5. Curb ramp detectable warning surfaces shall extend the full width of the ramp and in the direction of travel for 2' from the back of curb. Detectable warning surfaces shall be constructed in accordance with Specification 527. See Sheet 6 of 6 for detectable warning layouts. Transition slopes are not to have detectable warnings.
6. Where a curb ramp is constructed within existing curb, curb and gutter and/or sidewalk, the existing curb or curb and gutter shall be removed to the nearest joint beyond the curb transitions or to the extent that no remaining section of curb or curb and gutter is less than 5' long. The existing sidewalk shall be removed to the nearest joint beyond the transition slope or wall around or to the extent that no remaining section of sidewalk is less than 5' long. For details of transitions Sidewalk See Index 300.
7. Alpha-numeric identifications are for reference (plans, permits, etc.).
8. Public sidewalk curb ramps are to be paid for as follows:
   Ramps, constructed sidewalks, weld crosses, sidewalk landings and sidewalk curbs are to be paid for under the contract unit price for Sidewalk Concrete, (____ Thick), ST, Curb transitions and reconstructed curbs are to be paid for under the contract unit price for the parent curb, i.e., Curb Conc.,(Type ___), LF or Curb and Gutter Conc., (Type ___), LF.

   When a separate pay item for the removal and disposal of existing curb, curb and gutter, and/or sidewalk is not provided in the plans, the cost of removal and disposal of these features shall be included in the contract unit price for new curb, curb and gutter and/or sidewalk respectively.
9. Acceptance Criteria for Detectable Warnings:
   (a) The ramp detectable warning surface shall be complete and uniform in color and texture
   (b) 80% of the individual truncated domes must comply with the design criteria
   (c) There may be no more than 4 non-complying domes in any one square foot of surface
   (d) No two adjacent domes may be non-compliant
   (e) Surface may not deviate more than 0.80" from a true plane
10. All sidewalk surfaces, ramp surfaces, and landings with a cross slope shown in this Index to be 0.02 shall be 0.02 maximum. All ramp surfaces and ramp transition slopes with a slope shown in this Index to be 1:12 shall be 1:12 maximum.

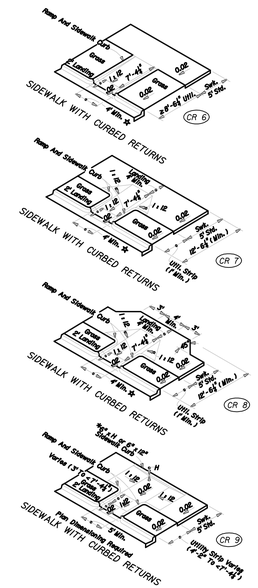

SIDEWALK WITH CURBED RETURNS (CR 6)

SIDEWALK WITH CURBED RETURNS (CR 7)

SIDEWALK WITH CURBED RETURNS (CR 8)

SIDEWALK WITH CURBED RETURNS (CR 9)

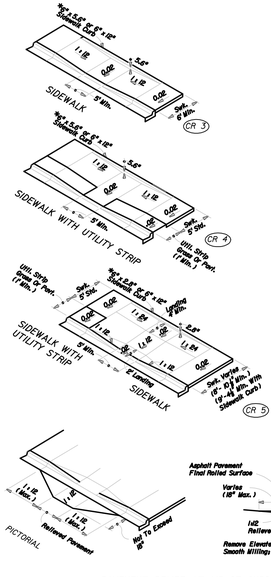

SIDEWALK WITH UTILITY STRIP (CR 4)

SIDEWALK WITH UTILITY STRIP (CR 5)

SIDEWALK WITH UTILITY STRIP (CR 1)

SIDEWALK WITH UTILITY STRIP (CR 2)

SECTION THROUGH RAMP RUN AND LANDINGS WITH UPPER LANDING AT NORMAL SIDEWALK ELEVATION

★ For BACK OF SIDEWALK CURB OR BUFFER TRANSITION And For RAMP AND SIDEWALK CURB OPTIONS See Sheet 4.

★ Ramp Widths For Curb Ramps CR 1, CR 2, CR 6, CR 7, And CR 8 May Be Reduced To 3' Min. In Restricted Conditions When Approved By The Engineer.

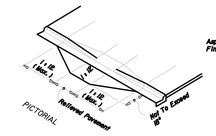

PAVEMENT RELIEF AT LIP OF CURB

DIMENSIONAL FEATURES FOR PUBLIC SIDEWALK CURB RAMPS WHERE RAMP AND LANDING DEPTH ARE NOT RESTRICTED BY RIGHT OF WAY

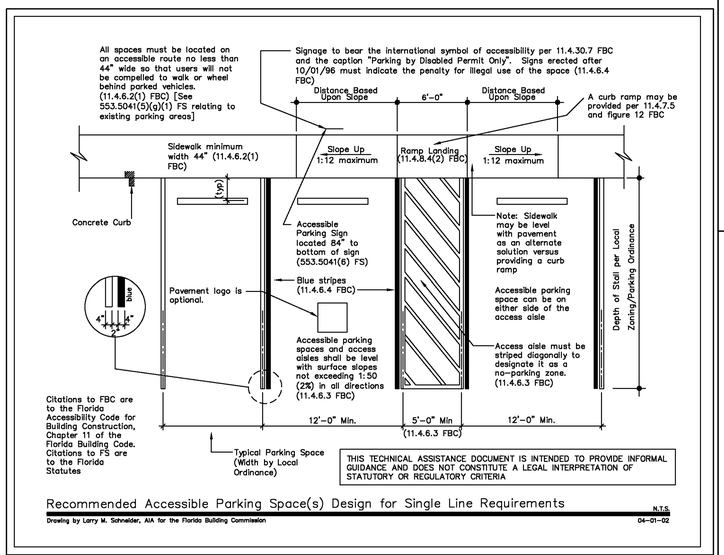

Recommended Accessible Parking Space(s) Design for Single Line Requirements

N.T.S.

Drawing by Larry M. Schneider, AIA for the Florida Building Commission — 04-01-02

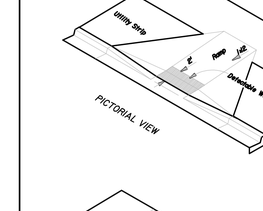


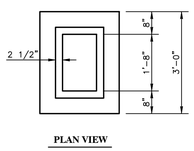

YARD DRAIN DETAIL

GRATE TYPE U.S.F. NO. 6145 OR APPROVED EQUAL

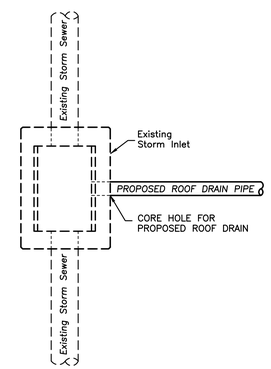

ROOF DRAIN CONNECTION DETAIL

N.T.S.

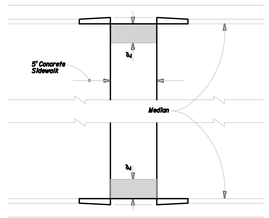

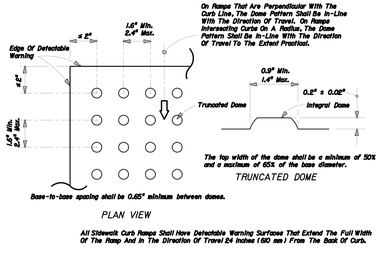

On Ramps That Are Perpendicular With The Curb Line, The Dome Pattern Shall Be In-Line With The Direction Of Travel. On Ramps Intersecting Curbs On A Radius, The Dome Pattern Shall Be In-Line With The Direction Of Travel To The Extent Practical.

All Sidewalk Curb Ramps Shall Have Detectable Warning Surfaces That Extend The Full Width Of The Ramp And In The Direction Of Travel 24 Inches (610 mm) From The Back Of Curb.

CURB RAMP DETECTABLE WARNING DETAIL

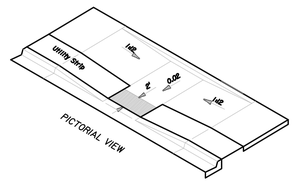

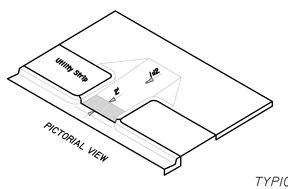

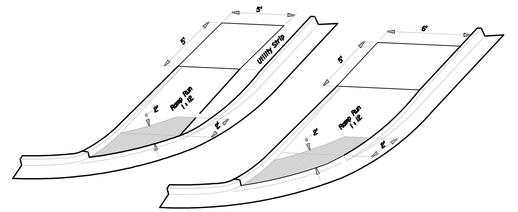

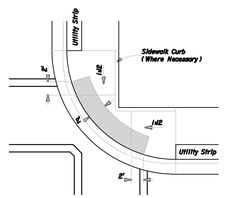

TYPICAL PLACEMENT OF DETECTABLE WARNING ON CURB RAMPS

DATE	DESCRIPTION	BY
	REVISIONS	

Engineering Business Certificate of Authorization No.: 26548
Fuxan Engineering, Inc.
15018 Maurine Cove Ln.
Odessa, Florida 33556
Phone: 813-244-6194
DAVID G. FUXAN P.E. NO. 33133 STATE OF FLORIDA PROFESSIONAL ENGINEER
DATE:
DAVID G. FUXAN P.E. NO. 33133
FLORIDA PROFESSIONAL ENGINEER

DRAINAGE DETAILS

JOB NO.	2015-MP-01
DESIGN	FUXAN
DRAWN	SOMERVILLE
DATE	12-18-2105
FILE	DD

ANAND VIHAR
2017 Redesign

PREPARED FOR: Anand Vihar, LLC

Elevations based on National Geodetic Vertical Datum 1929 (NGVD 29) Conversion from NGVD 29 to NAVD 88 = -0.83 Feet

SHEET 14 OF 20 SHEETS

SEE SHEET 17 FOR CONTINUATION

SEE SHEET 16 FOR CONTINUATION

SEE SHEET 17 FOR CONTINUATION

SEE SHEET 18 FOR CONTINUATION

YAMUNA WAY

NARMADA WAY

GODAVARI WAY

ANAND VIHAR DRIVE

MANSFIELD BLVD. 80' R/W — COLLECTOR

#1A #1B #2A #2B #6A #6B #6C #7A #7B #7C #8 #9 #10 #16A #16B #16C #17A #17B #17C #48 #49 #50 #51

EX. 6" SAN SVC W/ C.O.

EX. WATER SVC TO REMAIN (TYP.)

EX. MH Z-2 TOP 61.60 NE INV 54.45 NW INV 54.40

EX. MH Z-1 TOP 61.60 SE INV 54.10 NE INV 54.05

EX. SAN C.O. INV 55.80

EX. GREASE TRAP INV 55.80

EX. SAN C.O. TOP 62.30 INV 55.60

CLUBHOUSE FF EL = 63.00

EX. FIRE HYDRANT

EX. 8" FIRE

EX. 4" WM

EX. WATER SVC FROM FDP (TYP.) BDGS #10-#12)

EX. WATER SVC TO REMAIN

EX. 2" VALLEY GUTTER

EX. 12" (2)

CONNECT IRRIGATION TO EX. 4" PVC RM STUB

EX. FIRE HYDRANT (TYP)

EX. 3" METER W/ RPZ

EXISTING TRANSFORMER (TYP.)

EX. 15' PRIVATE UTILITY EASEMENT

EX. PLATTED PUBLIC UTILITY EASEMENT (PB 74, PG 61)

EX. 24" WATER SVC (TYP.)

EX. 6" SAN SVC WITH C.O. (TYP.)

EXISTING LIGHT POLE (TYP.)

EX. WATER SVC (TYP.)

EX. PLUGGED 8" FIRE

EX. 6" SAN SERVICE WITH CLEANOUT (TYP.)

EX. 6" SAN SVC W/ C.O. (TYP.)

EX. PLUGGED 4" FIRE

EX. 24" WATER SVC (TYP.)

EX. 8" SAN SVC W/ C.O.

EX. FIRE HYDRANT TO REMAIN (TYP)

EX. 6" SAN SVC W/ C.O. (TYP.)

EX. F.H.

EX. TRASH COMPACTOR

EX. FAUX GUARD HOUSE

EX. RETAINING WALL

EX. SIGN TOWER

EROSION CONTROL (TYP.)

WETLAND "53"
53
SH=60.05
NP=

WCA II

15' WETLAND BUFFER

SWFWMD WETLAND LINE

15.05' (MIN.)

MITIGATION AREA
M-26
0.55 AC±
(HERBACEOUS)

LITTORAL ZONE

FLOOD ZONE "A"

FLOOD ZONE "X"

FLOOD ZONE "AE" EL.60.83 (NGVD29) (60.0 NAVD88)

FLOOD ZONE "AE" EL.61.73 (NGVD29) (60.9 NAVD88)

310 LF EX. 8" SM

93 LF EX. 8" SM

215 LF EX. 8" SM

346 LF EX. 8" SM

PASCO COUNTY

HILLSBOROUGH COUNTY

32 33

N

80 40 0 40 80

SCALE: 1" = 40'

LEGEND

EXISTING	PROPOSED	
		WATER MAIN (WM)
		FIRE MAIN
		FIRE HYDRANT
		VALVE & BOX
		REDUCER
		PLUG
		BLOW-OFF
		BENDS
CO	CO	SANITARY SEWER (SM)

NOTE:
A separate plan and permit, issued to a contractor licensed by the Florida State Fire Marshal's Office, is required for the installation of underground fire lines.

PCU#96-102.33

CALL 48 HOURS BEFORE YOU DIG
IT'S THE LAW! DIAL 811
Know what's below. Call before you dig.
SUNSHINE STATE ONE CALL OF FLORIDA, INC.

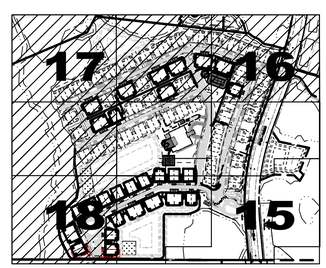

KEY MAP

DATE	DESCRIPTION	BY
03/24/2020	5. REVISED PER MINOR MODIFICATION & TO REFLECT COMPLETED WORK TO DATE	JS
1/04/2018	4. UPDATES PER PC UTILITIES COMMENTS	JS
11/29/2017	3. UPDATES PER COUNTY COMMENTS	JS
10/25/2017	2. UPDATES PER DEVELOPER REDESIGN	JS
3/15/2016	1. REVISED PER COUNTY COMMENTS AND OWNER SITE UPDATES	JS

REVISIONS

Engineering Business Certificate of Authorization No.: 26548

Fuxan Engineering, Inc.
No. 33133
15018 Maurine Cove Ln.
Odessa, Florida 33556
Phone: 813-244-6194

STATE OF FLORIDA PROFESSIONAL ENGINEER

DATE:
DAVID G. FUXAN, P.E. NO. 33133
FLORIDA PROFESSIONAL ENGINEER

WATER & SEWER PLAN (1)

JOB NO. 2015-MP-01	ANAND VIHAR 2017 Redesign
DESIGN FUXAN	
DRAWN SOMERVILLE	PREPARED FOR: Anand Vihar, LLC
DATE 10-10-2017	Elevations based on National Geodetic Vertical Datum 1929 (NGVD 29) Conversion from NGVD 29 to NAVD 88 = -0.83 Feet
FILE WSP	SHEET 15 OF 20 SHEETS

RES-3 MPUD

WETLAND "42J" 42J SH=59.20 NP=58.45

WCA I

MEADOW POINTE PARCEL 14 UNIT 1 PB 36, PG 101-105

WCA I

WETLAND "25" 25 SH=60.87 NP=60.32

MEADOW POINTE PARCEL 16 UNIT 3A PB 45, PG 127-134

HADDINGTON WAY

SEE SHEET 17 FOR CONTINUATION

SEE SHEET 18 FOR CONTINUATION

SEE SHEET 15 FOR CONTINUATION

15.00' (MIN.)

SWFWMD WETLAND LINE (TYP.)

15' WETLAND BUFFER (MIN.)

FLOOD ZONE "AE" EL.60.93 (NGVD29) (60.1 NAVD88)

FLOOD ZONE "X"

FLOOD ZONE "AE" EL 60.73 (NGVD29) (59.9 NAVD88)

15' TYPE 'B' BUFFER

FLOOD ZONE "AE" EL.61.73 (NGVD29) (60.9 NAVD88)

EX. CONCRETE TRANSFORMER PAD

EX. SEWAGE PUMP STATION TO REMAIN - SEE NOTE, THIS SHEET

ASPHALT DRIVE

20' TYPE 'D' BUFFER

EMERGENCY GATE SHALL INCLUDE SOS OR 3M OPTICOM EQUIPMENT

REVISIONS TO UTILITY CONNECTIONS FOR REDUCED SETBACK TYPICAL THROUGHOUT

EX. SAN CLEANOUTS ±15FT FROM EOP (TYP. BDGS #39-45)

EXISTING LIGHT POLE (TYP.)

EX. WATER SVC ±15FT FROM EOP (TYP. BDGS #39-#45)

EX. SAN C.O. TO REMAIN

EX. WATER SVC TO REMAIN

EX. F.H. TO REMAIN

CUT & RELOCATE 2" WATER SVC ±15FT FROM EOP

EX. SAN CLEANOUT ±15FT FROM EOP

GANGA WAY

NARMADA WAY

GAZEBO

TENNIS COURT

PARK

EXISTING MH B-2 TOP 60.50 SW INV 51.74 E INV 51.71

EX. WATER SVC TO REMAIN (TYP.)

EX. 15" SAN SVC W/ C.O. (TYP)

EX. 6" SAN SVC W/ C.O. (TYP)

EX. MH B-4 TOP 60.50 SE INV 53.71 SW INV 53.66 E INV 54.92 NE INV 53.63 NW INV

EX. 6" SAN SVC W/ C.O. (TYP.)

EX. FIRE HYDRANT (TYP)

EX. 8" SAN

EX. 8" FIRE

EX. 4" WM

EX. MH Z-2 TOP 61.60 NE INV 54.45 NW INV 54.40

EX. MH Z-1 TOP 61.60 SE INV 54.10 NE INV 54.15

EX. SAN C.O. INV 55.80

EX. GREASE TRAP INV 55.80

CLUBHOUSE FF EL = 63.00

EX. SAN C.O. TOP 62.30 INV 55.60

(WM) 4" G.V. (FIRE) 6" G.V. SEE ARCHITECTURAL PLANS FOR FDC AND POSITION INDICATOR VALVE

Pickleball Courts

EX. WATER SVC TO REMAIN (TYP.)

EX. LIGHT POLE (TYP.)

EX. SAN CLEANOUTS ±15FT FROM EOP (TYP. BDGS #10-12)

EX. WATER SVC ±15FT FROM EOP (TYP. BDGS #10-#12)

EX. WATER SVC-SQ REMAIN

EX. 32' PAVEMENT (2) 12' LANES W/ (2) 4' BIKE LANES

EX. 4' CONC. S/W

EX. 2' VALLEY GUTTER

EROSION CONTROL (TYP.)

MANSFIELD BLVD. 80' R/W MJR COLLECTOR

EX. 8"FM

FLOOD ZONE "A"

FLOOD ZONE "X"

FLOOD ZONE "AE" EL.61.73 (NGVD29) (60.9 NAVD88)

SWFWMD

FOXFORD LANE

CONNECT IRRIGATION TO EX. 4" PVC RM STUB

EX. FIRE HYDRANT (TYP)

EX. 3" METER W/ RPZ

EXISTING TRANSFORMER (TYP.)

EX. 15' PRIVATE UTILITY EASEMENT

EX. PLATTED PUBLIC UTILITY EASEMENT (PB 74, PG 61)

EX. 2" WATER SVC (TYP.)

EX. 6" SAN SVC WITH C.O. (TYP.)

EX. PLUGGED 8" FIRE

GODAVARI WAY

YAMUNA WAY

410' OF EX. 8" SAN

FLOOD ZONE "AE" EL.60.83 (NGVD29) (60.0 NAVD88)

FLOOD ZONE "X"

#1 #2 #3 #4 #5 #6 #7A #7B #7C #8 #9 #10 #11 #12 #13 #14 #15 #16A #16B #16C #17A #17B #17C #22 #23 #24 #25 #26 #27 #28 #29 #37 #38 #39 #40 #41 #42 #43 #44 #45 #46 #47 #48 #49 #50

N

80 40 0 40 80

SCALE: 1" = 40'

LEGEND

EXISTING	PROPOSED	
		WATER MAIN (WM)
		FIRE MAIN
		FIRE HYDRANT
		VALVE & BOX
		REDUCER
		PLUG
		BLOW-OFF
		BENDS
CO	CO	SANITARY SEWER (SM)

PCU#96-102.33

SEWAGE PUMP STATION NOTE:
EXISTING SANITARY SEWAGE PUMP STATION SHALL REMAIN. THE EXISTING STATION WAS APPROVED AND CONSTRUCTED TO SERVICE 330 UNITS. THE PROPOSED DEVELOPMENT WILL CONSIST OF 179 UNITS. THE PUMP STATION WILL BE ADEQUATE FOR THE ANTICIPATED FLOWS.

CALL 48 HOURS BEFORE YOU DIG
IT'S THE LAW! DIAL 811
Know what's below. Call before you dig.
811
SUNSHINE STATE ONE CALL OF FLORIDA, INC.

NOTE:
A separate plan and permit, issued to a contractor licensed by the Florida State Fire Marshal's Office, is required for the installation of underground fire lines.

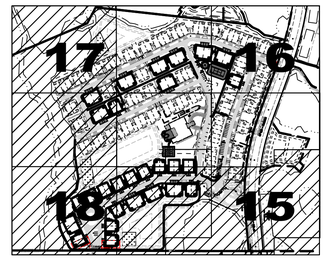

KEY MAP

DATE	DESCRIPTION	BY
03/24/2020	5. REVISED PER MINOR MODIFICATION & TO REFLECT COMPLETED WORK TO DATE	JS
1/04/2018	4. UPDATES PER PC UTILITIES COMMENTS	JS
11/29/2017	3. UPDATES PER COUNTY COMMENTS	JS
10/25/2017	2. UPDATES PER DEVELOPER REDESIGN	JS
3/15/2016	1. REVISED PER COUNTY COMMENTS AND OWNER SITE UPDATES	JS

REVISIONS

Engineering Business Certificate of Authorization No.: 26548
Fuxan Engineering, Inc.
No. 33133
15018 Maurine Cove Ln.
Odessa, Florida 33556
Phone: 813-244-6194
STATE OF FLORIDA
DAVID G. FUXAN P.E. NO. 33133
FLORIDA PROFESSIONAL ENGINEER

DATE:

WATER& SEWER PLAN (2)

JOB NO.	2015-MP-01
DESIGN	FUXAN
DRAWN	SOMERVILLE
DATE	10-10-2017
FILE	WSP

ANAND VIHAR
2017 Redesign

PREPARED FOR: Anand Vihar, LLC

Elevations based on National Geodetic Vertical Datum 1929 (NGVD 29) Conversion from NGVD 29 to NAVD 88 = -0.83 Feet

WETLAND "42J"

42J
SH=59.20
NP=58.45

WCA I

S.W.F.W.M.D. UPLAND PRESERVATION AREA "3B"
O.R. Book 5064, Page 1572

UPLAND PRESERVATION EASEMENT

15.00' (MIN.)

SWFWMD WETLAND LINE (TYP.)

15' WETLAND BUFFER (MIN.)

15.00'

25.00'

FLOOD ZONE "AE" EL.60.73 (NGVD29) (59.9 NAVD88)

FLOOD ZONE "X"

FLOOD ZONE "AE" EL.60.93 (NGVD29) (60.1 NAVD88)

FLOOD ZONE "AE" EL.60.83 (NGVD29) (60.0 NAVD88)

EROSION CONTROL (TYP.)

GANGA WAY

SARASWATI WAY

YAMUNA WAY

NARMADA WAY

#15 #16A #16B #16C #17A #17B #17C #18A #18B #18C #19 #20 #21 #22 #23 #24 #25 #26 #27 #28 #29 #30 #31 #32 #33 #34 #35 #36 #37 #38 #39 #40 #41

EX. F.H. TO REMAIN

EX. WATER SVC TO REMAIN

EX. SAN C.O. TO REMAIN

EXISTING MH S-2 TOP 60.50 INV 51.74 SW INV 51.71

EX. WATER SVC TO REMAIN (TYP.)

EX. MH B-4 TOP 60.50 SE INV 53.71 SW INV 53.66 NE INV 54.92 NW INV 53.63

EX. MH Z-2 TOP 61.60 SE INV 54.45 NE INV 54.40 NW INV

EX. MH Z-1 TOP 61.60 SE INV 54.10 NE INV 54.05

EX. SAN CLEANOUTS ±15FT FROM EOP (TYP. BDGS #39-45)

EXISTING LIGHT POLE (TYP.)

EX. WATER SVC ±15FT FROM EOP (TYP. BDGS #39-#45)

EX. WATER SVC TO REMAIN (TYP. BDGS #35-38)

EX. SAN C.O. TO REMAIN (TYP. BDGS #35-38)

EX. 6" SAN SVC W/ C.O.

EX. 6" SAN SVC W/ C.O. (TYP.)

EX. 16" SAN SVC W/ C.O. (TYP.)

EX. 8" SAN SVC W/ C.O. (TYP.)

EX. 6" SAN SVC W/ C.O. (TYP.)

EX. 6" SAN C.O. SVC W/ (TYP.)

EX. WATER SVC TO REMAIN (TYP.)

EX. WATER SVC ±15FT FROM EOP (TYP. BDGS #20-#31)

EX. FIRE HYDRANT (TYP.)

EX. WATER SVC TO REMAIN (TYP. BDGS #19, 32)

EX. SAN C.O. TO REMAIN (TYP. BDGS #19, 32)

EX. WATER SVC ±15FT FROM EOP (TYP. BDGS #33-#34)

EX. SAN CLEANOUT ±15FT FROM EOP

420 LF EX. 8" SAN

410.0' EX. 8" SAN

PLUGGED EX. FIRE

EX. FIRE HYDRANT

EX. WATER SVC TO REMAIN (TYP.)

EX. 6" SAN SVC W/ C.O. (TYP.)

EX. 8" SAN

EX. 6" SAN

EX. FIRE HYDRANT

EX. GREASE TRAP INV 55.80

EX. SAN C.O. INV 55.80

EX. SAN C.O. TOP 62.30 INV 55.60

CLUBHOUSE FF EL = 65.00

(WM) 4" G.V. (FIRE) 8" G.V. SEE ARCHITECTURAL PLANS FOR FDC AND POSITION INDICATOR VALVE

EX. TRANSFC

EX. TO

EX. TO

EX. FIRE HYDRANT

SEE SHEET 18 FOR CONTINUATION

SEE SHEET 16 FOR CONTINUATION

SEE SHEET 15 FOR CONTINUATION

WCA I

CONSERVATION AREA

UPLAND AREA "3B"

O.R. Book 5064, Page 1572

N

80 40 0 40 80

SCALE: 1" = 40'

LEGEND

EXISTING	PROPOSED	
		WATER MAIN (WM)
		FIRE MAIN
		FIRE HYDRANT
		VALVE & BOX
		REDUCER
		PLUG
		BLOW-OFF
		BENDS
CO	CO	SANITARY SEWER (SM)

PCU#96-102.33

CALL 48 HOURS BEFORE YOU DIG
IT'S THE LAW! DIAL 811
811 Know what's below. Call before you dig.
SUNSHINE STATE ONE CALL OF FLORIDA, INC.

NOTE:
A separate plan and permit, issued to a contractor licensed by the Florida State Fire Marshal's Office, is required for the installation of underground fire lines.

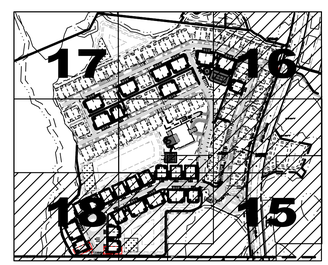

KEY MAP

DATE	DESCRIPTION	BY
03/24/2020	5. REVISED PER MINOR MODIFICATION & TO REFLECT COMPLETED WORK TO DATE	JS
1/04/2018	4. UPDATES PER PC UTILITIES COMMENTS	JS
11/29/2017	3. UPDATES PER COUNTY COMMENTS	JS
10/25/2017	2. UPDATES PER DEVELOPER REDESIGN	JS
3/15/2016	1. REVISED PER COUNTY COMMENTS AND OWNER SITE UPDATES	JS

REVISIONS

Engineering Business Certificate of Authorization No.: 26548

Fuxan Engineering, Inc.
No. 33133
15018 Maurine Cove Ln.
Odessa, Florida 33556
Phone: 813-244-6194
STATE OF FLORIDA
REGISTERED PROFESSIONAL ENGINEER

DATE:
DAVID G. FUXAN P.E. NO. 33133
FLORIDA PROFESSIONAL ENGINEER

WATER & SEWER PLAN (3)

JOB NO. 2015-MP-01	ANAND VIHAR 2017 Redesign
DESIGN FUXAN	
DRAWN SOMERVILLE	PREPARED FOR: Anand Vihar, LLC
DATE 10-10-2017	Elevations based on National Geodetic Vertical Datum 1929 (NGVD 29) Conversion from NGVD 29 to NAVD 88 = -0.83 Feet
FILE WSP	SHEET 17 OF 20 SHEETS

SEE SHEET 17 FOR CONTINUATION

SEE SHEET 16 FOR CONTINUATION

SEE SHEET 15 FOR CONTINUATION

WETLAND CONSERVATION AREA

WCA I

S.W.F.W.M.D. UPLAND PRESERVATION AREA "3B"

O.R. Book 5064, Page 1572

SARASWATI WAY

YAMUNA WAY

NARMADA WAY

ANAND VIHAR DRIVE

ANAND VIHAR DRIVE

EX. WATER SVC. ±15FT FROM EOP TYP. BDGS #20& #31)

EX. FIRE HYDRANT (TYP)

#20

#21

#32

EX. WATER SVC TO REMAIN BDGS #19, 32)

#19

EX. SAN C.O. TO REMAIN (TYP. BDGS #19, 32)

EX. 6" SAN SVC W/ C.O.

EX. 8" SAN

EX. WATER SVC TO REMAIN (TYP.)

EX. FIRE HYDRANT

PLUGGED EX. 4" FIRE

EX. 6" SAN SVC W/ C.O. (TYP.)

#18A

#18B

#18C

#17A

#17B

#17C

#16A

#16B

#16C

EX. MH Z-1 TOP 61.60 SE INV 54.10 NE INV 54.05

EX. MH Z-2 TOP 61.60 NE INV 54.45 NW INV 54.40

EX. SAN C.O. INV 55.80

EX. GREASE TRAP INV 55.80

EX. SAN C.O. TOP 62.30 INV 55.60

CLUBHOUSE FF EL = 63.00

(WM) 4" G.V. (FIRE) 8" G.V. SEE ARCHITECTURAL PLANS FOR FDC AND POSITION INDICATOR VALVE

EX. FIRE HYDRANT

EX. 8" FIRE SVC W/ (TYP.)

EX. 8" FIRE EX. 4" WM

EROSION CONTROL (TYP.)

FLOOD ZONE "AE" EL.60.83 (NGVD29) (60.0 NAVD88)

FLOOD ZONE "X"

#7A

#7B

#7C

#6A

#6B

#6C

#5A

#5B

#5C

#4A

#4B

#3A

#3B

#2A

#2B

#2C

#1A

#1B

EX. 2½" WATER SVC (TYP.)

EX. 6" SAN SERVICE WITH CLEANOUT (TYP.)

EX. PLUGGED 8" FIRE

EX. 6" SAN SVC W/ C.O. (TYP.)

EX. PLUGGED 4" FIRE

EX. 6" SAN SVC W/ C.O.

EX. 2½" WATER SVC. (TYP.)

EX. FIRE HYDRANT TO REMAIN (TYP)

EX. F.H.

EX. TRASH COMPACTOR

EX. FAU GUARD HOUS

EXISTING LIG POLE (TYI

93 LF EX. 8" SM

215 LF EX. 8" SM

RS .8 X3 .31 95C

EX LIGHT POLE (TYP.)

25.00' (TYP.)

SWFWMD WETLAND LINE

25' WETLAND BUFFER

UPLAND PRESERVATION EASEMENT

WETLAND "5.

53

SH=60.05

NP=

WCA II

PASCO COUNTY

HILLSBOROUGH COUNTY

N

80 40 0 40 80

SCALE: 1" = 40'

LEGEND

EXISTING	PROPOSED
	WATER MAIN (WM)
	FIRE MAIN
	FIRE HYDRANT
	VALVE & BOX
	REDUCER
	PLUG
	BLOW-OFF
	BENDS
CO	SANITARY SEWER (SM) CO

PCU#96-102.33

CALL 48 HOURS BEFORE YOU DIG

IT'S THE LAW! DIAL 811

811 Know what's below. Call before you dig.

SUNSHINE STATE ONE CALL OF FLORIDA, INC.

NOTE:
A separate plan and permit, issued to a contractor licensed by the Florida State Fire Marshal's Office, is required for the installation of underground fire lines.

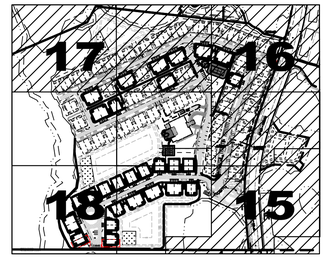

KEY MAP

DATE	DESCRIPTION	BY
03/24/2020	5. REVISED PER MINOR MODIFICATION & TO REFLECT COMPLETED WORK TO DATE	JS
1/04/2018	4. UPDATES PER PC UTILITIES COMMENTS	JS
11/29/2017	3. UPDATES PER COUNTY COMMENTS	JS
10/25/2017	2. UPDATES PER DEVELOPER REDESIGN	JS
3/15/2016	1. REVISED PER COUNTY COMMENTS AND OWNER SITE UPDATES	JS

REVISIONS

Engineering Business Certificate of Authorization No.: 26548

Fuxan Engineering, Inc.

15018 Maurine Cove Ln.
Odessa, Florida 33556
Phone: 813-244-6194

STATE OF FLORIDA DAVID G. FUXAN No. 33133 REGISTERED PROFESSIONAL ENGINEER

DATE:

DAVID G. FUXAN, P.E. NO. 33133
FLORIDA PROFESSIONAL ENGINEER

WATER & SEWER PLAN (4)

JOB NO.	2015-MP-01
DESIGN	FUXAN
DRAWN	SOMERVILLE
DATE	10-10-2017
FILE	WSP

ANAND VIHAR
2017 Redesign

PREPARED FOR: Anand Vihar, LLC

Elevations based on National Geodetic Vertical Datum 1929 (NGVD 29) Conversion from NGVD 29 to NAVD 88 = -0.83 Feet

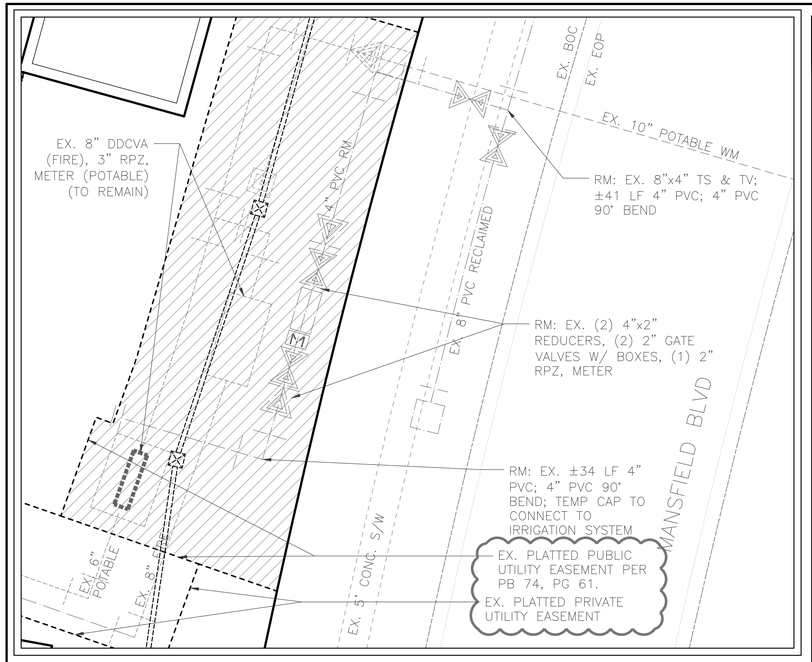

EX. POTABLE, FIRE, RECLAIMED WATER CONNECTION DETAIL

SCALE: 1" = 10'

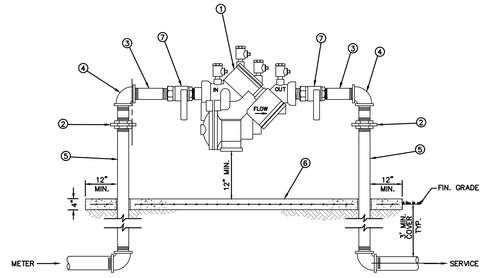

MATERIALS		
ITEM	QUANT.	DESCRIPTION
1	1	BACKFLOW PREVENTER ASSEMBLY, REDUCED PRESSURE ZONE
2	2	UNIONS – GALV.
3	2	NIPPLES – BRASS
4	2	ELBOWS – GALV. 90°
5	2	RISER – GALV.
6	*	CONCRETE SLAB
7	2	BALL VALVES – BRASS OR S.S. (PROVIDED WITH BFP ASS'Y)

NOTE:
- FIELD ADJUST AND CUT ITEM 5 TO THE PROPER LENGTH.
- MINIMUM CLEARANCE OF 24" TO BE MAINTAINED AROUND DEVICE FOR TESTING.
- ENTIRE ASSEMBLY TO BE PAINTED SAFETY BLUE.
- CONCRETE SLAB TO EXTEND 12" MIN. AROUND ENTIRE DEVICE.
- DEVICE MUST BE LISTED WITH THE UNIVERSITY OF SOUTHERN CALIFORNIA FOUNDATION FOR CROSS CONNECTION CONTROL AND HYDRAULIC RESEARCH.

CREATED 02/24/03	REDUCED PRESSURE BACKFLOW PREVENTER (SINGLE SERVICE: 3/4", 1", 1–1/2", 2")	PROVIDED FOR INFORMATIONAL PURPOSES ONLY. NO MODIFICATIONS WITHOUT WRITTEN PCU APPROVAL
REVISED	PASCO COUNTY UTILITIES	DETAIL 11

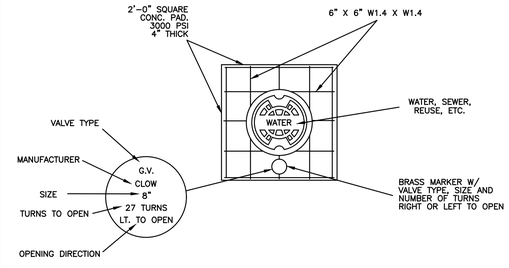

TYPICAL CONCRETE VALVE PAD

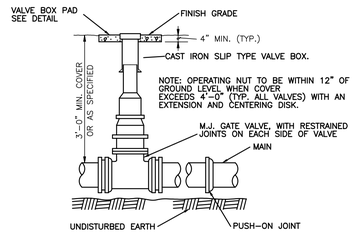

CREATED 02/24/03	VALVE BOX DETAIL SLIP TYPE	PROVIDED FOR INFORMATIONAL PURPOSES ONLY. NO MODIFICATIONS WITHOUT WRITTEN PCU APPROVAL
REVISED	PASCO COUNTY UTILITIES	DETAIL 27

PIPE RESTRAINT LENGTHS IN FEET COMMON FITTINGS

WATER MAINS - TEST PRESSURE 150 PSI

PIPE SIZE	FITTING TYPE 11-1/4°	22-1/2°	45°	90°	DEAD END
4"	2'	4'	8'	20'	45'
6"	3'	6'	12'	28'	63'
8"	4'	7'	15'	36'	82'
10"	4'	9'	18'	43'	98'
12"	5'	10'	21'	50'	116'
16"	6'	13'	26'	63'	148'
20"	7'	15'	31'	76'	179'
24"	9'	17'	36'	87'	208'

FORCE MAINS - TEST PRESSURE 100 PSI

PIPE SIZE	FITTING TYPE 11-1/4°	22-1/2°	45°	90°	DEAD END
4"	1'	3'	6'	13'	30'
6"	2'	4'	8'	19'	42'
8"	2'	5'	10'	24'	55'
10"	3'	6'	12'	29'	66'
12"	3'	7'	14'	34'	77'
16"	4'	8'	18'	42'	99'
20"	5'	10'	21'	50'	119'
24"	6'	11'	24'	58'	139'

RESTRAINT LENGTHS ARE MEASURED FROM THE CENTER LINE OF THE FITTING ALONG THE PIPE IN BOTH DIRECTIONS (EXCEPT DEAD ENDS).

CREATED 02/24/03	RESTRAINED JOINT TABLE COMMON FITTINGS	PROVIDED FOR INFORMATIONAL PURPOSES ONLY. NO MODIFICATIONS WITHOUT WRITTEN PCU APPROVAL
REVISED	PASCO COUNTY UTILITIES	DETAIL 28

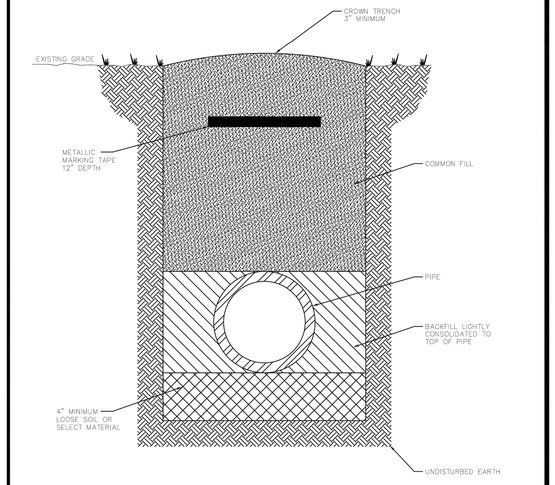

NOTES:
- LOOSE SOIL OR SELECT MATERIAL IS NATIVE SOIL EXCAVATED FROM THE TRENCH FREE OF ROCKS AND FOREIGN MATERIAL.
- COMMON FILL TO BE PLACED AND COMPACTED IN 12" LAYERS. ROLLING EQUIPMENT SHALL NOT BE USED FOR COMPACTION UNTIL A MINIMUM OF 18" OF COMMON FILL HAS BEEN PLACED AND COMPACTED OVER THE PIPE. THREE FEET OF FILL SHALL BE PLACED BEFORE A HYDROHAMMER MAY BE USED FOR COMPACTION.

NTS

CREATED 02/24/03	PIPE LAYING CONDITIONS STANDARD UNPAVED AREAS	PROVIDED FOR INFORMATIONAL PURPOSES ONLY. NO MODIFICATIONS WITHOUT WRITTEN PCU APPROVAL
REVISED	PASCO COUNTY UTILITIES	DETAIL 35

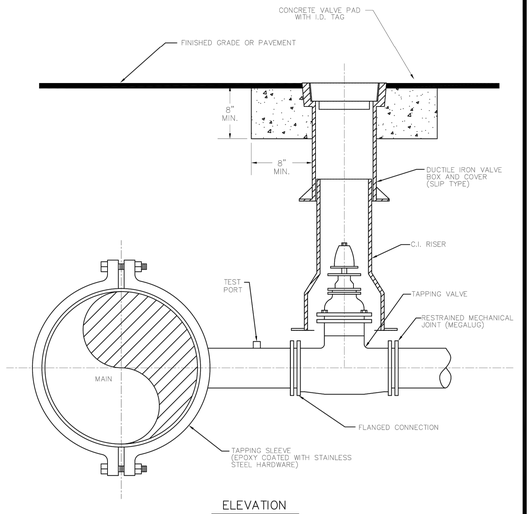

ELEVATION

NOTES:
- SADDLE CONNECTION WILL BE TESTED TO 150 PSI PRIOR TO TAPPING MAIN.
- MECHANICAL JOINTS/UNDERGROUND PIPING SHALL BE RESTRAINED AS SPECIFIED BY COUNTY/ENGINEER.
- VALVE EXTENSION ROD SHALL BE UTILIZED, AS NECESSARY, SO THAT VALVE OPERATING NUT IS A MAXIMUM OF 3' BELOW GRADE.

CREATED 02/24/03	WATER, REUSE, AND FORCE MAIN TAPPING DETAIL W/ VALVE LOCATION	PROVIDED FOR INFORMATIONAL PURPOSES ONLY. NO MODIFICATIONS WITHOUT WRITTEN PCU APPROVAL
REVISED	PASCO COUNTY UTILITIES	DETAIL 37

PIPE RESTRAINT LENGTHS IN FEET TEES (BRANCH SIDE)

WATER MAINS - TEST PRESSURE 150 PSI

RUN SIZE	BRANCH SIZE 3"	4"	6"	8"	10"	12"	16"	20"	24"
3"	6'	14'	30'	—	—	—	—	—	—
4"	2'	11'	28'	44'	—	—	—	—	—
6"	1'	2'	22'	40'	52'	—	—	—	—
8"	1'	1'	16'	35'	48'	62'	—	—	—
10"	1'	1'	10'	30'	44'	58'	83'	—	—
12"	1'	1'	3'	25'	40'	55'	80'	103'	—
16"	1'	1'	1'	14'	31'	48'	75'	98'	119'
20"	1'	1'	1'	2'	22'	40'	69'	94'	116'
24"	1'	1'	1'	1'	11'	31'	63'	89'	111'

RESTRAINT LENGTHS ARE MEASURED FROM THE CENTER LINE OF THE TEE ALONG THE BRANCH FOR THE DISTANCE INDICATED. A MINIMUM OF 5 FEET OF RESTRAINED PIPE MUST BE INSTALLED ON BOTH RUNS OF THE TEE. MEGALUG TYPE RESTRAINERS ARE REQUIRED ON ALL JOINTS.

CREATED 02/24/03	RESTRAINED JOINT TABLE TEES (BRANCH SIDE)	PROVIDED FOR INFORMATIONAL PURPOSES ONLY. NO MODIFICATIONS WITHOUT WRITTEN PCU APPROVAL
REVISED	PASCO COUNTY UTILITIES	DETAIL 29

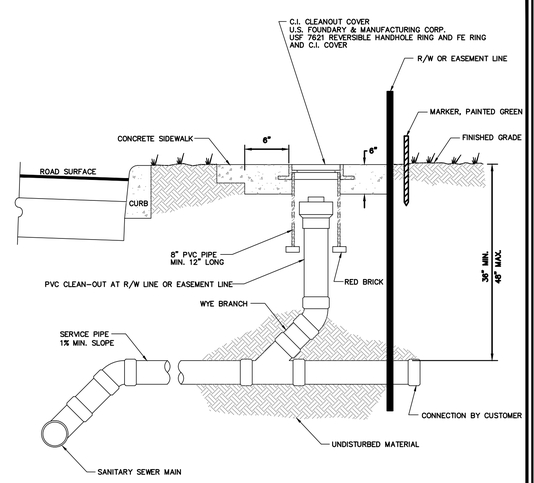

NTS

CREATED 02/24/03	SANITARY SEWER – SINGLE WYE CONNECTION AND TYPICAL CLEAN–OUT	PROVIDED FOR INFORMATIONAL PURPOSES ONLY. NO MODIFICATIONS WITHOUT WRITTEN PCU APPROVAL
REVISED	PASCO COUNTY UTILITIES	DETAIL 42

PCU#96–102.33

DATE	DESCRIPTION	BY
1/04/2018	4. UPDATES PER PC UTILITIES COMMENTS	JS
11/29/2017	3. REVISED PER COUNTY COMMENTS	JS
2/xx/2017	2. REVISED PER IRRIGATION DEMAND	JS
5/20/2016	1. REVISED PER COUNTY COMMENTS	JS

REVISIONS

Engineering Business Certificate of Authorization No.: 26548

Fuxan Engineering, Inc.
15018 Maurine Cove Ln.
Odessa, Florida 33556
Phone: 813-244-6194

DAVID G. FUXAN No. 33133 STATE OF FLORIDA PROFESSIONAL ENGINEER

DATE:
DAVID G. FUXAN P.E. NO. 33133
FLORIDA PROFESSIONAL ENGINEER

WATER SYSTEM DETAILS

JOB NO.	2015–MP–01
DESIGN	FUXAN
DRAWN	SOMERVILLE
DATE	12–18–2015
FILE	WD

ANAND VIHAR
2017 Redesign

PREPARED FOR: Anand Vihar, LLC

Elevations based on National Geodetic Vertical Datum 1929 (NGVD 29) Conversion from NGVD 29 to NAVD 88 = -0.83 Feet

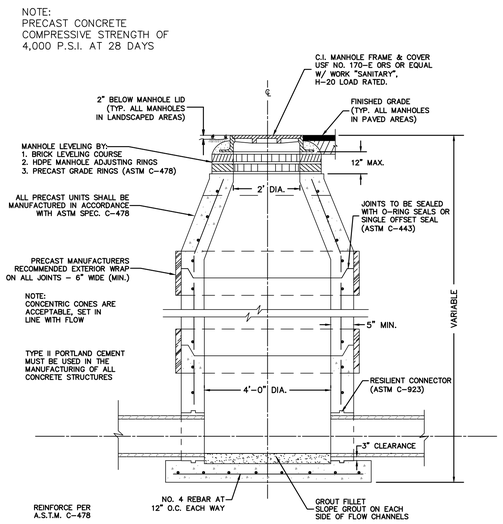

NOTES:
1. MANUFACTURERS RECOMMENDED EXTERNAL WRAP MUST BE USED ON ALL MANHOLE JOINTS AND RISER RINGS.
2. PASCO COUNTY WILL HAVE THE OPTION OF SPECIFYING THE TYPE OF INTERIOR LINING/COATING TO BE INSTALLED FOR EACH INDIVIDUAL MANHOLE.
3. PASCO COUNTY SHALL HAVE THE OPTION OF REQUIRING A NEGATIVE PRESSURE TEST FOR ANY MANHOLE PER ASTM C-1244.
4. LIFT HOLES MUST NOT PENETRATE WALLS. LIFT INSERTS AND LIFT BARS MUST BE USED WHEN LIFTING MANHOLES.

CREATED 02/24/03	STANDARD MANHOLE	PROVIDED FOR INFORMATIONAL PURPOSES ONLY. NO MODIFICATIONS WITHOUT WRITTEN PCU APPROVAL.
REVISED 10/06/03	PASCO COUNTY UTILITIES	DETAIL 38

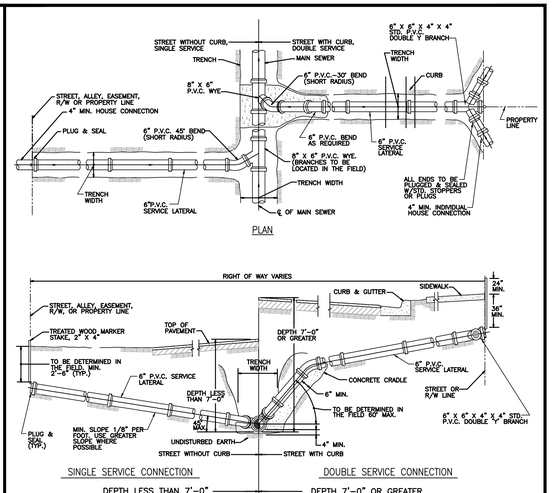

NOTE:
- CONTRACTOR SHALL MAKE, ON A CLEAN SET OF PLANS, THE FINAL STATIONING OR DISTANCE AND DIRECTION FROM MANHOLE OF EACH SERVICE LATERAL AND THEN GIVE TO ENGINEER FOR RECORD PURPOSES.
- PROVIDE 2" x 4" PRESSURE TREATED WOOD MARKER STAKE AT ALL SANITARY SERVICES (INCLUDE IN PIPE PRICE), TOP OF STAKE TO BE PAINTED WITH GREEN PAINT.
- THE MINIMUM DIAMETER OF ALL SERVICE LATERALS SHALL BE 6 INCHES.

CREATED 02/24/03	SEWER LATERAL CONNECTION	PROVIDED FOR INFORMATIONAL PURPOSES ONLY. NO MODIFICATIONS WITHOUT WRITTEN PCU APPROVAL.
REVISED	PASCO COUNTY UTILITIES	DETAIL 41

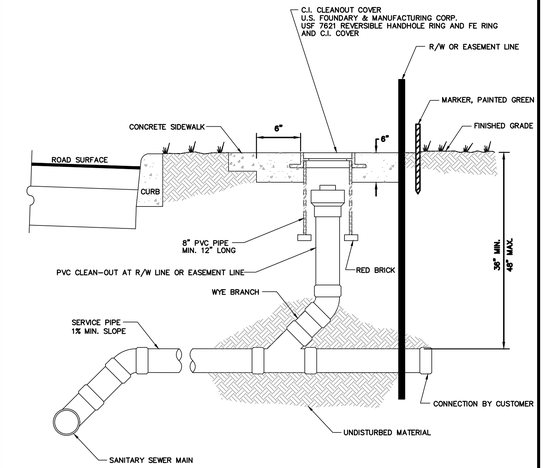

NTS

CREATED 02/24/03	SANITARY SEWER - SINGLE WYE CONNECTION AND TYPICAL CLEAN-OUT	PROVIDED FOR INFORMATIONAL PURPOSES ONLY. NO MODIFICATIONS WITHOUT WRITTEN PCU APPROVAL.
REVISED	PASCO COUNTY UTILITIES	DETAIL 42

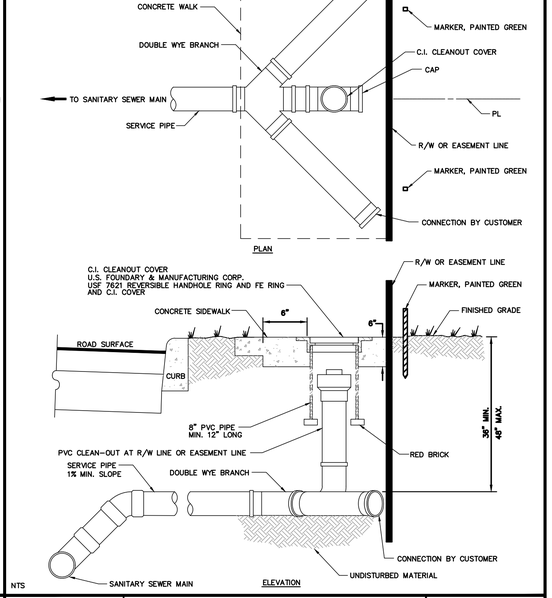

NTS

CREATED 02/24/03	SANITARY SEWER - DOUBLE WYE CONNECTION AND TYPICAL CLEAN-OUT	PROVIDED FOR INFORMATIONAL PURPOSES ONLY. NO MODIFICATIONS WITHOUT WRITTEN PCU APPROVAL.
REVISED	PASCO COUNTY UTILITIES	DETAIL 43

DATE	DESCRIPTION	BY
03/03/15	REMOVED DETAIL 39	DM

REVISIONS

Engineering Business Certificate of Authorization No.: 26548
Fuxan Engineering, Inc.
15018 Maurine Cove Ln.
Odessa, Florida 33556
Phone: 813-244-6194

DATE:

DAVID G. FUXAN P.E. NO. 33133
FLORIDA PROFESSIONAL ENGINEER

SANITARY SEWER SYSTEM DETAILS

JOB NO.	ANAND VIHAR 2017 Redesign
2015-MP-01	
DESIGN FUXAN	
DRAWN SOMERVILLE	PREPARED FOR: Anand Vihar, LLC
DATE 12-18-2015	Elevations based on National Geodetic Vertical Datum 1929 (NGVD 29) Conversion from NGVD 29 to NAVD 88 = -0.83 Feet
FILE SD	SHEET 20 OF 20 SHEETS

SURVEYOR'S NOTES:

1) Easements, rights-of-ways, set back lines, reservations, agreements and other similar matters taken from Chicago Title Insurance Company, Commitment for Title Insurance No. 4928855, with an effective date of August 20, 2014.

2) This survey is limited to above ground visible improvements along and near the boundary lines, except as shown hereon, and that nothing below the ground was located including, but not limited to foundations (footings), utilities, etc.

3) Bearings shown hereon are based on The South boundary of the Southwest 1/4 of Section 33, Township 26 South, Range 20 East, Pasco County, Florida, having a Grid bearing of N.89°52'26"W. The Grid Bearings as shown hereon refer to the State Plane Coordinate System, North American Horizontal Datum of 1983 (NAD 83-1990 ADJUSTMENT) for the West Zone of Florida.

4) Legal description as shown hereon taken from the above referenced Title Commitment.

N

200 100 0 100 200

SCALE: 1" = 100'

LINE DATA TABLE

NO.	BEARING	DISTANCE
L1	S.49°45'05"E.	25.42
L2	S.65°46'46"E.	36.32
L3	S.50°20'14"E.	44.10
L4	S.79°30'44"E.	39.95
L5	S.74°40'18"E.	78.60

CURVE DATA TABLE

NO.	RADIUS	DELTA	ARC	TANGENT	CHORD	BEARING
1	1240.00	08°15'28"	178.71	89.51	178.56	(S)N.00°52'16"W.(E)
2	1240.00	16°44'32"	362.34	182.47	361.05	(N)S.11°37'44"W.(E)
3	1960.00	04°40'18"	159.81	79.95	159.76	S.17°39'51"W.
4	3.00	53°53'34"	2.82	1.53	2.72	(S)N.66°24'13"E.(W)
5	35.00	10°25'27"	6.37	3.19	6.36	(S)N.34°14'43"E.(W)

LEGEND

PRM	Permanent Reference Monument 4"x4" Concrete Monument LB No. 148 (Found)
FIP	Found 1/2" Iron Pipe LB148 (Unless Noted Otherwise)
O.R.	Official Record Book
Pg.	Page
S.W.F.W.M.D.	Southwest Floria Water Management District

MEADOW POINTE PARCEL 11 UNIT 2
P.B. 36, Pg.s 85–89

MEADOW POINTE PARCEL 14 UNIT 1
P.B. 36, Pg.s 101–105

BLOCK 1

Southwest corner of MEADOW POINTE PARCEL 14 UNIT 1 Permanent Reference Monument 4"x4" Concrete Monument LB No. 148 (Found)

Southerly boundary of MEADOW POINTE PARCEL 14 UNIT 1

Permanent Reference Monument 4"x4" Concrete Monument LB No. 148 (Found)

Southerly boundary of MEADOW POINTE PARCEL 11 UNIT 2

Permanent Reference Monument 4"x4" Concrete Monument LB No. 148 (Found)

Southernmost corner of MEADOW POINTE PARCEL 11 UNIT 2 Permanent Reference Monument 4"x4" Concrete Monument LB No. 148 (Found)

CHORD Retrace Line

S.83°40'26"E. 513.96'

N.28°00'00"W. 101.04'

456.36'

N.67°04'53"E. 557.98'

N.67°00'00"E.

861.60'

347.64'

PARCEL VI
(See Sheets No. 4 & 5 for Occupation, Etc.)

(Not Included) (O.R. 7226, Pg. 1220)

PARKING PARCEL 1

ACCESS PARCEL (O.R. 7226, Pg. 1220)

PARKING PARCEL 2

PARKING PARCEL 3

(N)S.84°00'00"E.(W) 109.36'

(N)S.70°00'00"E.(W) 40.49'

(N)S.25°00'00"E.(W) 14.37'

(N)S.70°00'00"E.(W) 86.68'

(N)S.25°00'00"E.(W) 69.84'

L1 L2 L3 L4 L5 C1 C2 C3

1/2" Iron Pipe with Cap No. LB 148 (Found)

S.W.F.W.M.D. UPLAND PRESERVATION AREA "38" O.R. 5064, PAGE 1572

PARCEL V
(See Sheets No. 4–6 for Occupation, Etc.)

MEADOW POINTE PARCEL 14 UNIT 3 PHASE 2
Plat Book 61, Pages 133–140

PHASE 2 PHASE 1

N.55°44'35"E. S.55°44'35"W. 37.87'

N.65°00'00"E. 74.00'

S.25°00'00"E. 72.00'

S.65°00'00"W. 170.00'

N.25°00'00"W. 142.00'

S.65°00'00"W. N.65°00'00"E. 365.00'

N.25°00'00"W. 72.00'

(N)S.26°27'27"W.(E) 126.05'

(N)S.14°29'27"W.(E) 184.42'

(N)S.07°24'47"W.(E) 179.38'

(N)S.05°00'00"E.(W) 213.85'

(N)S.82°40'12"E.(W) 82.99'

(N)S.86°39'00"E.(W) 115.33'

PARCEL III
Not Applicable

PARCEL I
(See Sheet No. 3 for Occupation, Etc.)

PARCEL II
(See Sheets No. 3 & 4 for Occupation, Etc.)

WELLINGTON AT MEADOW POINTE CONDOMINIUM No. 1 (O.R. 7226, Page 451)

WELLINGTON AT MEADOW POINTE CONDOMINIUM No. 2 (O.R. 7226, Page 546)

BOULEVARD
32' ASPHALT PAVEMENT

S.20°00'00"W. 400.00'

MANSFIELD
80' RIGHT-OF-WAY
(O.R. 4594, Pg. 415)

DETAIL "A"
Not to Scale

WELLINGTON AT MEADOW POINTE A CONDOMINIUM

(N)S.82°40'12"E.(W) 82.99'

(N)S.60°58'00"E.(W) 45.43'

(N)S.86°39'00"E.(W) 115.33'

MEADOW POINTE PARCEL 14 UNIT 3 PHASE 1

See DETAIL "A"

MEADOW POINTE PARCEL 14 UNIT 3 PHASE 1
Plat Book 60, Pages 85–94

MEADOW POINTE PARCEL 8 UNIT 7
P.B. 36, Pg.s 1–5

N.25°00'00"W. 691.90'

Easterly boundary of MEADOW POINTE PARCEL 8 UNIT 7

Northerly boundary of MEADOW POINTE PARCEL 14 UNIT 3 PHASE 1

917.32'

S.65°00'00"W. N.65°00'00"E.

WETLAND

Westerly boundary of MEADOW POINTE PARCEL 14 UNIT 3 PHASE 1

SWFWMD Wetland Line

S.W.F.W.M.D. UPLAND PRESERVATION AREA "38" O.R. 5061, PAGE 1572

PARCEL V

POINT OF BEGINNING
Permanent Reference Monument 4"x4" Concrete Monument LB No. 148 (Found)

949.32'

250.42'

N.89°50'36"W. 1314.55'

TOWNSHIP 26 SOUTH
TOWNSHIP 27 SOUTH

PASCO COUNTY
HILLSBOROUGH COUNTY

32 33 5 4

Southwest corner of MEADOW POINTE PARCEL 14 UNIT 3 PHASE 1, Southeast corner of MEADOW POINTE PARCEL 8 UNIT 7

South boundary of the Southeast 1/4 of Section 32, Township 26 South, Range 20 East and the South boundary of MEADOW POINTE PARCEL 14 UNIT 3 PHASE 1

(S)N.89°52'26"W.(E) 151.70'

Southwest corner of the right-of-way for MANSFIELD BOULEVARD

South boundary of the Southwest 1/4 of Section 33, Township 26 South, Range 20 East

POINT OF COMMENCEMENT
Southeast corner of Section 32, Township 26 South, Range 20 East, also Southwest corner of Section 33, Township 26 South, Range 20 East

SCHEDULE B - SECTION 2 - EXCEPTIONS

Items 1 - 5: Not a Matter of Survey.

Item 6: Refer to Drainage Easement reserved In the Warranty Deed recorded in Official Records Book 709, page 271, of the public records of Pasco County, Florida, (blanket easement)

Item 7: Refer to Notice of Adoption of Development Order recorded In Official Records Book 1748, page 1508, and Notices of Adoptions thereto recorded in Official Records Book 2082, page 1500, Official Records Book 3669, page 1350, and Official Records Book 3901, page 40 and Resolution recorded in Official Records Book 1772, page 1070, all of the Public Records of Pasco County, Florida,

Item 8: Refer to Water and Sewer Easement recorded in Official Records Book 1782, page 119, of the public records of Pasco County, Florida, (blanket easement)

Item 9: Refer to Terms, covenants, conditions and other matters contained In the Potable Water, Reclaimed Water & Wastewater Treatment Service Agreement as recorded in Official Records Book 1865, page 1497, of the public records of Pasco County, Florida.

Item 10: Refer to Declaration of Consent to Jurisdiction of Community Development District and to Imposition of Special Assessments recorded In Official Records Book 3483, page 1112, of the public records of Pasco County, Florida,

Item 11: Refer to Terms, covenants, conditions and other matters contained in the Real Estate Purchase Agreement between Trout Creek Properties, LLC and Wellington Developers, LLC, dated August 3, 2004, a Memorandum of which was recorded September 2, 2005, in Official Records Book 6566, page 141, of the public records of Pasco County, Florida,

Item 12: Refer to Conservation Easement recorded in Official Records Book 5064, page 1572, of the public records of Pasco County, Florida, (plotted hereon)

Item 13: Refer to Easement in favor of Tampa Electric Company recorded in Official Records Book 7121, Page 1672, of the Public Records of Pasco County, Florida, (blanket easement)

Item 14: Refer to Restrictions, covenants, conditions and easements as contained in Master Declaration of Covenants, Conditions and Restrictions of Welling At Meadow Pointe, dated November 8, 2005 and recorded November 15, 2005, in Official Records Book 6691, Page 1080, and affected by Notice of Terminating Class B Membership Status recorded in Official Records Book 8781, Page 1134, of the Public Records of Pasco County, Florida,

Item 15: Not a matter of survey.

Item 16: Refer to all terms, conditions, easements, restrictions, reservations and other provisions of that certain Declaration of Condominium of Wellington At Meadow Pointe Condominium No. 1, and the exhibits and attachments thereto, dated September 15, 2006 and recorded October 16, 2005, in Official Records Book 7226, Page 451, of the Public Records of Pasco County, Florida, and First Amendment recorded In Official Records Book 7549, Page 1324, and Second Amendment recorded in Official Records Book 7960, Page 1949, of said Public Records.

Item 17: Refer to all terms, conditions, easements, restrictions, reservations and other provisions of that certain Declaration of Condominium of Wellington At Meadow Pointe Condominium No, 2, and the exhibits and attachments thereto, dated September 15, 2006, and recorded October 15, 2005, in Official Records Book 7226, Page 546, of the Public Records of Pasco County, Florida,

Item 18: Refer to Restrictions, covenants, conditions and easements as contained on the Plat of Meadow Pointe Parcel 14 Unit 3 Phase 1, recorded in Plat Book 60, Pages 85 through 94, inclusive, of the Public Records of Pasco County, Florida,

Item 19: Refer to Restrictions, covenants, conditions and easements as contained on the Plat of Meadow Pointe Parcel 14 Unit 3 Phase 2, recorded in Plat Book 61, Pages 133 through 140, inclusive, of the Public Records of Pasco County, Florida,

Item 20: Not a Matter of Survey.

CERTIFIED TO:
Turn Stone Group, LLC
Chicago Title Insurance Company

I certify that this map or plat and the survey on which it is based were made in accordance with the "Minimum Standard Detail Requirements for ALTA/ACSM Land Title Surveys", jointly established and adopted by ALTA and ACSM in 2011 and includes Table A Requirements 1, 3, 4, 8, 9, 11(a), 16, and 18 thereof. Pursuant to the Accuracy Standards as adopted by ALTA, NSPS, and ACSM and in effect on the date of the certification, the undersigned further certifies that the positional uncertainties resulting from the survey measurements made on the survey do not exceed the allowable positional tolerance.

GEOPOINT SURVEYING, INC.

Jack M. Greene
Florida Professional Surveyor and Mapper # 6506

PARCEL I:

Lots 1-7, Block 12, of MEADOW POINTE PARCEL 14 UNIT 3 PHASE 1, according to the Plat thereof recorded in Plat Book 60, Page 85, of the Public Records of Pasco County, Florida.

TOGETHER WITH:

PARCEL II:

DESCRIPTION; A parcel of land lying in the Southeast 1/4 of Section 32, Township 26 South, Range 20 East, and In the Southwest 1/4 of Section 33, Township 26 South, Range 20 East, Pasco County, Florida, and being more particularly described as follows:

Commence at the Southwest corner of said Section 33, run thence along the South boundary of said Southwest 1/4 of Section 33, South 89° 52' 26" East, 151.70 feet to a point on the Westerly right-of-way line of MANSFIELD BOULEVARD, as recorded in Official Records Book 4594, Page 415, of the Public Records of Pasco County, Florida; thence along said Westerly right-of-way line, the following two (2) courses: 1) North 05° 00' 00" West, 213.85 feet to a point of curvature; 2) Northerly, 178.71 feet along the arc of a curve to the right having a radius of 1240.00 feet and a central angle of 08° 15' 28" (chord bearing North 00° 52' 16" West, 178.56 feet) to the POINT OF BEGINNING; thence North 86° 39' 00" West, 115.33 feet to a point of curvature; thence Southwesterly, 2.82 feet along the arc of a curve to the left having a radius of 3.00 feet and a central angle of 53° 53' 34" (chord bearing South 66° 24' 13" West, 2.72 feet) to a point of compound curvature; thence Southwesterly, 6.37 feet along the arc of a curve to the left having a radius of 35.00 feet and a central angle of 10° 25' 27" (chord bearing South 34° 14' 43" West, 6.36 feet); thence North 60° 58' 00" West, 45.43 feet; thence North 82° 40' 12" West, 78.00 feet; thence North 07° 24' 47" East, 179.26 feet; thence North 14° 29' 24" East, 183.80 feet; thence North 20° 57' 37" East, 127.88 feet; thence North 20° 00'00" East, 126.50 feet; thence South 70° 00'00" East, 75.00 feet; thence South 20° 00' 00" West, 6.00 feet; thence South 70° 00' 00" East, 36.00 feet; thence South 20° 00' 00" West, 5.00 feet; thence South 70° 00' 00" East, 36.00 feet; thence South 20° 00' 00" West, 82.67 feet; South 70° 00' 00" East, 90.00 feet to a point on the aforesaid Westerly right-of-way of MANSFIELD BOULEVARD; thence along said Westerly right-of-way line, the following two (2) courses: 1); thence South 20° 00' 00" West, 110.33 feet to a point of curvature; 2) Southerly, 362.34 feet along the arc of a curve to the left having a radius of 1240.00 feet and a central angle of 16° 44' 32" (chord bearing South 11° 37' 44" West, 361.05 feet) to the POINT OF BEGINNING.

LESS AND EXCEPT:

WELLINGTON AT MEADOW POINTE CONDOMINIUM NO. 1, according to the Declaration of Condominium (Phase I) recorded in Official Records Book 7226, Page 451, and First Amendment to Declaration of Condominium (Phase I and II) recorded in Official Records Book 7549, page 1324, and Second Amendment to Declaration of Condominium (Phase II) recorded in Official Records Book 7960, Page 1949, of the Public Records of Pasco County, Florida.

ALSO LESS AND EXCEPT:

WELLINGTON AT MEADOW POINTE CONDOMINIUM NO. 2, according to the Declaration of Condominium (Phase I) recorded in Official Records Book 7226, Page 546, of the Public Records of Pasco County, Florida,

ALSO LESS AND EXCEPT:

LESS and EXCEPT that portion conveyed to Wellington at Meadow Pointe Homeowners Association, Inc., by Warranty Deed recorded in Official Records Book 7332, Page 1222, of the Public Records of Pasco County, Florida.

PARCEL II NOW KNOWN AS:

PROPOSED PHASE III OF WELLINGTON AT MEADOW POINTE CONDOMINIUM No. 1

DESCRIPTION; A parcel of land lying in Sections 32 and 33, Township 26 South, Range 20 East, Pasco County, Florida, and being more particularly described as follows:

Commence at the Southwest corner of said Section 33, said point also being a point on the South boundary of MEADOW POINTE PARCEL 14 UNIT 3 PHASE 1, according to the plat thereof as recorded in Plat Book 60, Pages 85 through 94, inclusive, of the Public Records of Pasco County, Florida, run thence along the South boundary of the Southwest 1/4 of said Section 33 and said South boundary of MEADOW POINTE PARCEL 14 UNIT 3 PHASE 1, S.89°52'26"E., 151.70 feet to a point on the Westerly right-of-way line of MANSFIELD BOULEVARD, as recorded in Official Records Book 4594, Page 415, of the Public Records of Pasco County, Florida, said point also being the Southeast corner of said MEADOW POINTE PARCEL 14 UNIT 3 PHASE 1; thence along said Westerly right-of-way line of MANSFIELD BOULEVARD, also being the Easterly boundary of said MEADOW POINTE PARCEL 14 UNIT 3 PHASE 1, the following two (2) courses: 1) N.05°00'00"W., 213.85 feet to a point of curvature; 2) Northerly, 178.71 feet along the arc of a curve to the right having a radius of 1240.00 feet and a central angle of 08°15'28" (chord bearing N.00°52'16"W., 178.56 feet) to the Northeast corner of TRACT "B-1" of said MEADOW POINTE PARCEL 14 UNIT 3 PHASE 1; thence continue along said Easterly boundary of MEADOW POINTE PARCEL 14 UNIT 3 PHASE 1, the following eight (8) courses: 1) N.86°39'00"W., 115.33 feet to a point of curvature; 2) Southwesterly, 2.82 feet along the arc of a curve to the left having a radius of 3.00 feet and a central angle of 53°53'34" (chord bearing S.66°24'13"W., 2.72 feet) to a point of compound curvature; 3) Southwesterly, 6.37 feet along the arc of a curve to the left having a radius of 35.00 feet and a central angle of 10°25'27" (chord bearing S.34°14'43"W., 6.36 feet); 4) N.60°58'00"W., 45.43 feet; 5) N.82°40'12"W., 82.99 feet; 6) N.07°24'47"E., 179.58 feet ; 7) N.14°29'24"E., 184.42 feet to the POINT OF BEGINNING; 8) N.20°57'27"E., 128.05 feet; thence S.70°00'00"E., 80.00 feet; thence S.20°00'00"W., 77.50 feet to a point of curvature; thence Southerly, 47.72 feet along the arc of a curve to the left having a radius of 1402.00 feet and a central angle of 01°57'00" (chord bearing S.19°01'30"W., 47.71 feet); thence N.71°57'00"W., 83.00 feet to the POINT OF BEGINNING.

AND

PROPOSED PHASE II OF WELLINGTON AT MEADOW POINTE CONDOMINIUM No. 2

DESCRIPTION; A parcel of land lying in the Southwest 1/4 of Section 33, Township 26 South, Range 20 East, Pasco County, Florida, and being more particularly described as follows:

Commence at the Southwest corner of said Section 33, said point also being a point on the South boundary of MEADOW POINTE PARCEL 14 UNIT 3 PHASE 1, according to the plat thereof as recorded in Plat Book 60, Pages 85 through 94, inclusive, of the Public Records of Pasco County, Florida, run thence along the South boundary of the Southwest 1/4 of said Section 33 and said South boundary of MEADOW POINTE PARCEL 14 UNIT 3 PHASE 1, S.89°52'26"E., 151.70 feet to a point on the Westerly right-of-way line of MANSFIELD BOULEVARD, as recorded in Official Records Book 4594, Page 415, of the Public Records of Pasco County, Florida, said point also being the Southeast corner of said MEADOW POINTE PARCEL 14 UNIT 3 PHASE 1; thence along said Westerly right-of-way line of MANSFIELD BOULEVARD, also being the Easterly boundary of said MEADOW POINTE PARCEL 14 UNIT 3 PHASE 1, N.05°00'00"W., 213.85 feet to a point of curvature; thence continue along said Westerly right-of-way line of MANSFIELD BOULEVARD, also being the Easterly boundary of said MEADOW POINTE PARCEL 14 UNIT 3 PHASE 1 and the Northerly extension thereof, Northerly, 377.61 feet along the arc of a curve to the right having a radius of 1240.00 feet and a central angle of 17°26'53" (chord bearing N.03°43'27"E., 376.16 feet) to the POINT OF BEGINNING; thence N.77°33'07"W., 20.11 feet; thence N.12°26'53"E., 12.50 feet; thence N.77°33'07"W., 0.50 feet to a point of curvature; thence Northwesterly, 7.07 feet along the arc of a curve to the right having a radius of 4.50 feet and a central angle of 90°00'00" (chord bearing N.32°33'07"W., 6.36 feet) to a point of tangency; thence N.12°26'53"E., 19.00 feet; thence N.77°33'07"W., 64.40 feet to a point on a curve; thence Northerly, 139.30 feet along the arc of a curve to the right having a radius of 1330.00 feet and a central angle of 06°00'03" (chord bearing N.16°59'59"E., 139.23 feet) to a point of tangency; thence N.20°00'00"E., 38.33 feet; thence S.70°00'00"E., 60.50 feet; thence N.20°00'00"E., 19.00 feet to a point of curvature; thence Northeasterly, 7.07 feet along the arc of a curve to the right having a radius of 4.50 feet and a central angle of 90°00'00" (chord bearing N.65°00'00"E., 6.36 feet) to a point of tangency; thence S.70°00'00"E., 12.50 feet; thence N.20°00'00"E., 24.50 feet to a point on the aforesaid Westerly right-of-way line of MANSFIELD BOULEVARD; thence along said Westerly right-of-way line of MANSFIELD BOULEVARD, the following two (2) courses: 1) S.20°00'00"W., 74.33 feet to a point of curvature, 2) Southerly, 163.44 feet along the arc of a curve to the left having a radius of 1240.00 feet and a central angle of 07°33'07" (chord bearing S.16°13'27"W., 163.32 feet) to the POINT OF BEGINNING .

AND

PROPOSED PHASE III OF WELLINGTON AT MEADOW POINTE CONDOMINIUM No, 2

DESCRIPTION; A parcel of land lying in Sections 32 and 33, Township 26 South, Range 20 East, Pasco County, Florida, and being more particularly described as follows:

Commence at the Southwest corner of said Section 33, said point also being a point on the South boundary of MEADOW POINTE PARCEL 14 UNIT 3 PHASE 1, according to the plat thereof as recorded in Plat Book 60, Pages 85 through 94, inclusive, of the Public Records of Pasco County, Florida, run thence along the South boundary of the Southwest 1/4 of said Section 33 and said South boundary of MEADOW POINTE PARCEL 14 UNIT 3 PHASE 1, S.89°52'26"E., 151.70 feet to a point on the Westerly right-of-way line of MANSFIELD BOULEVARD, as recorded in Official Records Book 4594, Page 415, of the Public Records of Pasco County, Florida, said point also being the Southeast corner of said MEADOW POINTE PARCEL 14 UNIT 3 PHASE 1; thence along said Westerly right-of-way line of MANSFIELD BOULEVARD, also being the Easterly boundary of said MEADOW POINTE PARCEL 14 UNIT 3 PHASE 1, the following two (2) courses: 1) N.05°00'00"W., 213.85 feet to a point of curvature; thence Northwesterly, 178.71 feet along the arc of a curve to the right having a radius of 1240.00 feet and a central angle of 08°15'28" (chord bearing N.00°52'16"W., 178.56 feet) to the Northeast corner of TRACT "B-1" of said MEADOW POINTE PARCEL 14 UNIT 3 PHASE 1; thence continue along said Easterly boundary of MEADOW POINTE PARCEL 14 UNIT 3 PHASE 1, the following eight (8) courses: 1) N.86°39'00"W., 115.33 feet to a point of curvature; 2) Southwesterly, 2.82 feet along the arc of a curve to the left having a radius of 3.00 feet and a central angle of 53°53'34" (chord bearing S.66°24'13"W., 2.72 feet) to a point of compound curvature; 3) Southwesterly, 6.37 feet along the arc of a curve to the left having a radius of 35.00 feet and a central angle of 10°25'27" (chord bearing S.34°14'43"W., 6.36 feet); 4) N.60°58'00"W., 45.43 feet; 5) N.82°40'12"W., 82.99 feet; 6) N.07°24'47"E., 179.58 feet; 7) N.14°29'24"E., 184.42 feet; 8) N.20°57'27"E., 128.05 feet to the POINT OF BEGINNING; thence N.20°00'00"E., 121.50 feet; thence S.70°00'00"E., 80.00 feet; thence S.20°00'00"W., 121.50 feet; thence N.70°00'00"W., 80.00 feet to the POINT OF BEGINNING .

PARCEL III:

N /A

PARCEL IV:

All of WELLINGTON AT MEADOW POINTE CONDOMINIUM NO, 2, according to the Declaration of Condominium (Phase I) recorded in Official Records Book 7226, Page 546, of the Public Records of Pasco County, Florida,

PARCEL V:

All of MEADOW POINTE PARCEL 14 UNIT 3 PHASE 2 recorded in Plat Book 61, Page 133, of the Public Records of Pasco County, Florida,

Together with:

PARCEL VI:

DESCRIPTION; A parcel of land lying in the Southeast 1/4 of Section 32, Township 26 South, Range 20 East, and in the Southwest 1/4 of Section 33, Township 26 South, Range 20 East, Pasco County, Florida, and being more particularly described as follows:

Commence at the Southwest corner of said Section 33, run thence along the South boundary of said Southwest 1/4 of Section 33, South 89° 52' 26" East, 151.70 feet to a point on the Westerly right-of-way line of MANSFIELD BOULEVARD, as recorded in Official Records Book 4594, Page 415, of the Public Records of Pasco County, Florida; thence along said Westerly right-of-way line, the following three (3) courses: 1) North 05° 00' 00" West, 213.85 feet to a point of curvature; 2) Northerly, 541.05 feet along the arc of a curve to the right having a radius of 1240.00 feet and a central angle of 25° 00' 00" (chord bearing North 07° 30' 00" East, 536.77 feet) to a point of tangency; 3) North 20° 00' 00" East, 110.33 feet to the POINT OF BEGINNING; thence North 70° 00' 00" West, 90.00 feet; thence North 20° 00' 00" East, 82.67 feet; thence N.70°00'00"W., 36.00 feet; thence N.20°00'00"E., 5.00 feet; thence N.70°00'00"W., 80.00 feet to a point on the Easterly boundary of MEADOW POINTE PARCEL 14 UNIT 3, according to the plat thereof as recorded in Plat Book 61, Pages 133 through 140, inclusive, of the Public Records of Pasco County, Florida; thence along said Easterly boundary, the following 6 (six) courses: 1) continue N.70°00'00"W., 86.68 feet; 2) N.25°00'00"W., 14.37 feet; 3) N.20°00'00"E., 69.84 feet; 4) N.70°00'00"W., 40.49 feet; 5) N.84°00'00"W., 109.36 feet; 6) N.09°30'00"W., 158.80 feet to a point on the Southerly boundary of MEADOW POINTE PARCEL 14 UNIT 1, according to the plat thereof as recorded in Plat Book 36, pages 101 through 105, inclusive, of the public records of Pasco County, Florida; thence along said Southerly boundary, the following six (6) courses: 1) South 83° 40' 26" East, 347.64 feet; 2) South 49° 45' 05" East, 25.42 feet; 3) South 65° 46' 46" East, 36.32 feet; 4) South 50° 20' 14" East, 44.10 feet; 5) South 79° 30' 44" East, 39.95 feet; 6) South 74° 40' 18" East, 78.60 feet to a point on a curve on the aforesaid Westerly right-of-way line of MANSFIELD BOULEVARD; thence along said Westerly right-of-way line, the following two (2) courses: 1) Southerly, 159.81 feet along the arc of a curve to the right having a radius of 1960.00 feet and a central angle of 04° 40' 18" (chord bearing South 17° 39' 51" West, 159.76 feet) to a point of tangency; 2) South 20° 00' 00" West, 189.67 feet to the POINT OF BEGINNING.

LESS and EXCEPT that portion conveyed to Wellington at Meadow Pointe Homeowners Association, Inc., by Warranty Deed recorded in Official Records Book 7332, Page 1222, of the Public Records of Pasco County, Florida.

ALTA/ACSM LAND TITLE SURVEY
WELLINGTON AT MEADOW POINTE
SHEET 1 OF 7 SHEETS

Last Date of Field Survey: 9/10/14

This Survey Prepared For: *TURN STONE GROUP, LLC*

REVISIONS

Description	Date	Dwn.	Ck'd	P.C.	Order No.

SURVEYOR'S CERTIFICATE

This certifies that a survey of the hereon described property was made under my supervision and meets the Minimum Technical Standards set forth by the Florida Board of Professional Surveyors & Mappers in Chapter 5J–17, Florida Administrative Code, pursuant to Section 472.027, Florida Statutes.

Jack M. Greene
FLORIDA PROFESSIONAL SURVEYOR & MAPPER NO. 6506

NOT VALID WITHOUT THE SIGNATURE AND THE ORIGINAL RAISED SEAL OF A FLORIDA LICENSED SURVEYOR AND MAPPER

GeoPoint Surveying, Inc.
1403 E. 5th Avenue
Tampa, Florida 33605
www.geopointsurvey.com
Phone: (813) 248-8888
Fax: (813) 248-2266
Licensed Business Number LB 7768

Drawn:SEC	Checked: JMG	P.C.: CF,MJ	Data File: MP14S–ALTA*
Date: 9/10/14	Dwg:MP14–3–ALTA(SHT1)	Order No.: SUR–10–040	

Sections 32 & 33, Township 26 South, Range 20 East

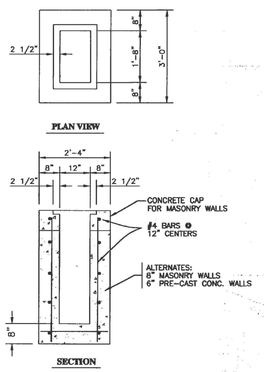

YARD DRAIN DETAIL

GRATE TYPE U.S.F. NO. 6145
OR APPROVED EQUAL

STRUCTURE NO.	STRUCTURE TYPE & SIZE	STRUCTURE TOP ELEV.	LINE TYPE	LINE DIAM. INCHES	LINE LENGTH FEET	LINE SLOPE %	LINE INVERT ELEV. UPPER END	LINE INVERT ELEV. LOWER END	LINE FALL IN FEET	STRUCTURE LOCATION & REMARKS
1	TYPE "C" GRATE TOP INLET	60.30	RCP	18	241	0.16	56.80	56.41	0.39	
2	TYPE "C" GRATE TOP INLET	60.30	RCP	18	178	0.16	56.41	56.13	0.28	
3	TYPE "C" GRATE TOP INLET	60.30	RCP	24	257	0.11	55.63	55.35	0.28	
7	TYPE "E" GRATE TOP INLET									
4	TYPE "C" GRATE TOP INLET	~~60.30~~ 61.00	RCP	18	101	0.34	56.80	56.46	0.34	RAISED TOP TO 61.00
6	TYPE "D" GRATE TOP INLET									
5	TYPE "C" GRATE TOP INLET	60.30	RCP	18	215	0.16	56.80	56.46	0.34	
6	TYPE "C" GRATE TOP INLET	60.30	RCP	18	190	0.32	56.46	55.85	0.61	
7	TYPE "D" GRATE TOP INLET	60.30	RCP	36	130	0.42	54.35	53.80	0.55	
8	MITERED END SECTION	NA								
9	TYPE "C" GRATE TOP INLET	60.30	RCP	18	232	0.37	56.80	56.43	0.37	(SE) CONNECTED 12" PVC @ INV EL. 57.95 (S) 6" U.D. @ INV. 57.95
10	TYPE "C" GRATE TOP INLET	60.30	RCP	24	215	0.24	55.93	55.69	0.24	
12	TYPE "E" GRATE TOP INLET									
11	TYPE "C" GRATE TOP INLET	~~60.30~~ 61.00	RCP	18	101	0.16	56.98	56.82	0.16	RAISED TOP TO 61.00
12	TYPE "C" GRATE TOP INLET	60.30	RCP	24	118	0.11	56.32	56.19	0.13	
14	TYPE "E" GRATE TOP INLET									
13	TYPE "C" GRATE TOP INLET	60.30	RCP	18	97	0.16	56.80	56.64	0.16	
14	TYPE "D" GRATE TOP INLET	60.30	RCP	36	125	1.08	55.14	53.80	1.34	(S) CONNECTED 36" RCP @ INV EL. 55.14
15	MITERED END SECTION									
18	TYPE "C" GRATE TOP INLET	60.30	RCP	18	113	0.18	56.50	56.32	0.34	
17	TYPE "C" GRATE TOP INLET	60.30	RCP	18	134	0.21	56.32	56.10	0.61	
18	TYPE "C" GRATE TOP INLET	60.30	RCP	24	113	0.12	55.60	55.48	0.34	(N,S) CONNECTED 6" U.D. @ INV EL. 55.60
19	TYPE "C" GRATE TOP INLET	60.30	RCP	24	132	0.15	55.48	55.34	0.61	(SW) CONNECTED 30" RCP @ INV EL. 55.48; (N,S) 6" U.D. @ INV. 55.48
20	TYPE "D" GRATE TOP INLET	60.30	RCP	36	131	0.54	54.34	53.80	0.55	
21	MITERED END SECTION	NA								
22	TYPE "C" GRATE TOP INLET	60.50	RCP	18	113	0.16	57.00	56.82	0.18	
23	TYPE "P" MANHOLE	62.30	RCP	18	328	0.16	56.82	56.29	0.52	
24	TYPE "C" GRATE TOP INLET	60.50	RCP	18	171	0.16	56.29	56.02	0.27	
26	TYPE "D" GRATE TOP INLET									
25	TYPE "C" GRATE TOP INLET	60.50	RCP	18	229	0.43	57.00	56.02	0.98	
26	TYPE "C" GRATE TOP INLET	60.50	RCP	24	122	0.42	55.52	55.00	0.51	
27	MITERED END SECTION	NA								
28	TYPE "C" GRATE TOP INLET	60.56	RCP	18	116	0.17	55.86	55.66	0.20	
29	TYPE "P" MANHOLE	60.50	RCP	18	104	0.16	55.66	55.50	0.17	(N) CONNECTED 18" RCP @ INV EL. 55.50
30	MITERED END SECTION	NA								

STRUCTURE NO.	STRUCTURE TYPE & SIZE	STRUCTURE TOP ELEV.	LINE TYPE	LINE DIAM. INCHES	LINE LENGTH FEET	LINE SLOPE %	LINE INVERT ELEV. UPPER END	LINE INVERT ELEV. LOWER END	LINE FALL IN FEET	STRUCTURE LOCATION & REMARKS
31	TYPE "C" GRATE TOP INLET	61.96	RCP	18	91	0.16	57.71	57.56	0.15	
32	MITERED END SECTION	NA								
33	OUTLET CONTROL STRUCTURE A	NA	RCP	24	21	0.95	55.80	55.60	0.20	
34	MITERED END SECTION	NA								
35	OUTLET CONTROL STRUCTURE B	NA	RCP	24	30	0.67	56.30	56.10	0.20	
36	MITERED END SECTION	NA								
37	OUTLET CONTROL STRUCTURE C	NA	RCP	24	26	0.08	56.50	56.48	0.02	
38	TYPE "P" MANHOLE	62.30	RCP	24	305	0.06	56.48	56.30	0.18	
39	MITERED END SECTION	NA								
40	OUTLET CONTROL STRUCTURE D	NA	RCP	18	114	0.05	59.05	58.99	0.06	
41	MITERED END SECTION	NA								

SWFWMD PERMITTED DRAWINGS

SWFWMD

JUL - 8 2005

RECEIVED

OPEN

DATE	DESCRIPTION	BY
7/7/05	STR 7, 12, 14	JPA
6/08/05	STR 28, 29	JPA
5/11/05	SWFWMD COMMENTS	JPA

REVISIONS

Engineering Business Certificate of Authorization No.: 148
HEIDT & ASSOCIATES, Inc.
Tampa • Fort Myers • Sarasota-Manatee
Tampa Office
2212 Swann Avenue
Tampa, Florida 33606
Phone: 813-253-5311
Pinellas: 727-442-8636
Pasco: 727-842-2401
FAX: 813-253-2478
DATE:
WILLIAM P. BAHLKE P.E. NO. 32621
FLORIDA PROFESSIONAL ENGINEER

DRAINAGE STRUCTURE DATA

JOB NO.	PDH MP 008
DESIGN	ANGELO
DRAWN	ANGELO
DATE	01-12-2005
FILE	ST

MEADOW POINTE PARCEL 14 UNIT 3

PREPARED FOR: **PREMIER DESIGN HOMES OF FLORIDA**

Elevations based on National Geodetic Vertical Datum 1929 (NGVD 29)
Conversion from NGVD 29 to NAVD 88 = -0.83 Feet

SHEET 7 OF 16 SHEETS

4400S010.DWG

07-07-05 3:40PM HEIDT & ASSOC. JOEA:P:\MEADOW POINTE\PARCEL 14-3\ENGINEERING\ST.DWG

DATE	DESCRIPTION	BY
5/20/2016	2. UPDATED PER COUNTY COMMENTS	JS
3/15/2016	1. ADDED SHEET PER COUNTY COMMENTS	JS

REVISIONS

Engineering Business Certificate of Authorization No.: 26548
Fuxan Engineering, Inc.
15018 Maurine Cove Ln.
Odessa, Florida 33556
Phone: 813-244-6194
DAVID G. FUXAN
No. 33133
STATE OF FLORIDA
PROFESSIONAL ENGINEER
DATE:
DAVID G. FUXAN P.E. NO. 33133
FLORIDA PROFESSIONAL ENGINEER

EXISTING STRUCTURE DATA SHEET

JOB NO.	2015-MP-01
DESIGN	FUXAN
DRAWN	SOMERVILLE
DATE	10-18-2017
FILE	ESTR

ANAND VIHAR
2017 Redesign

PREPARED FOR: Anand Vihar, LLC

Elevations based on National Geodetic Vertical Datum 1929 (NGVD 29)
Conversion from NGVD 29 to NAVD 88 = -0.83 Feet

SHEET 1 OF 1 SHEETS

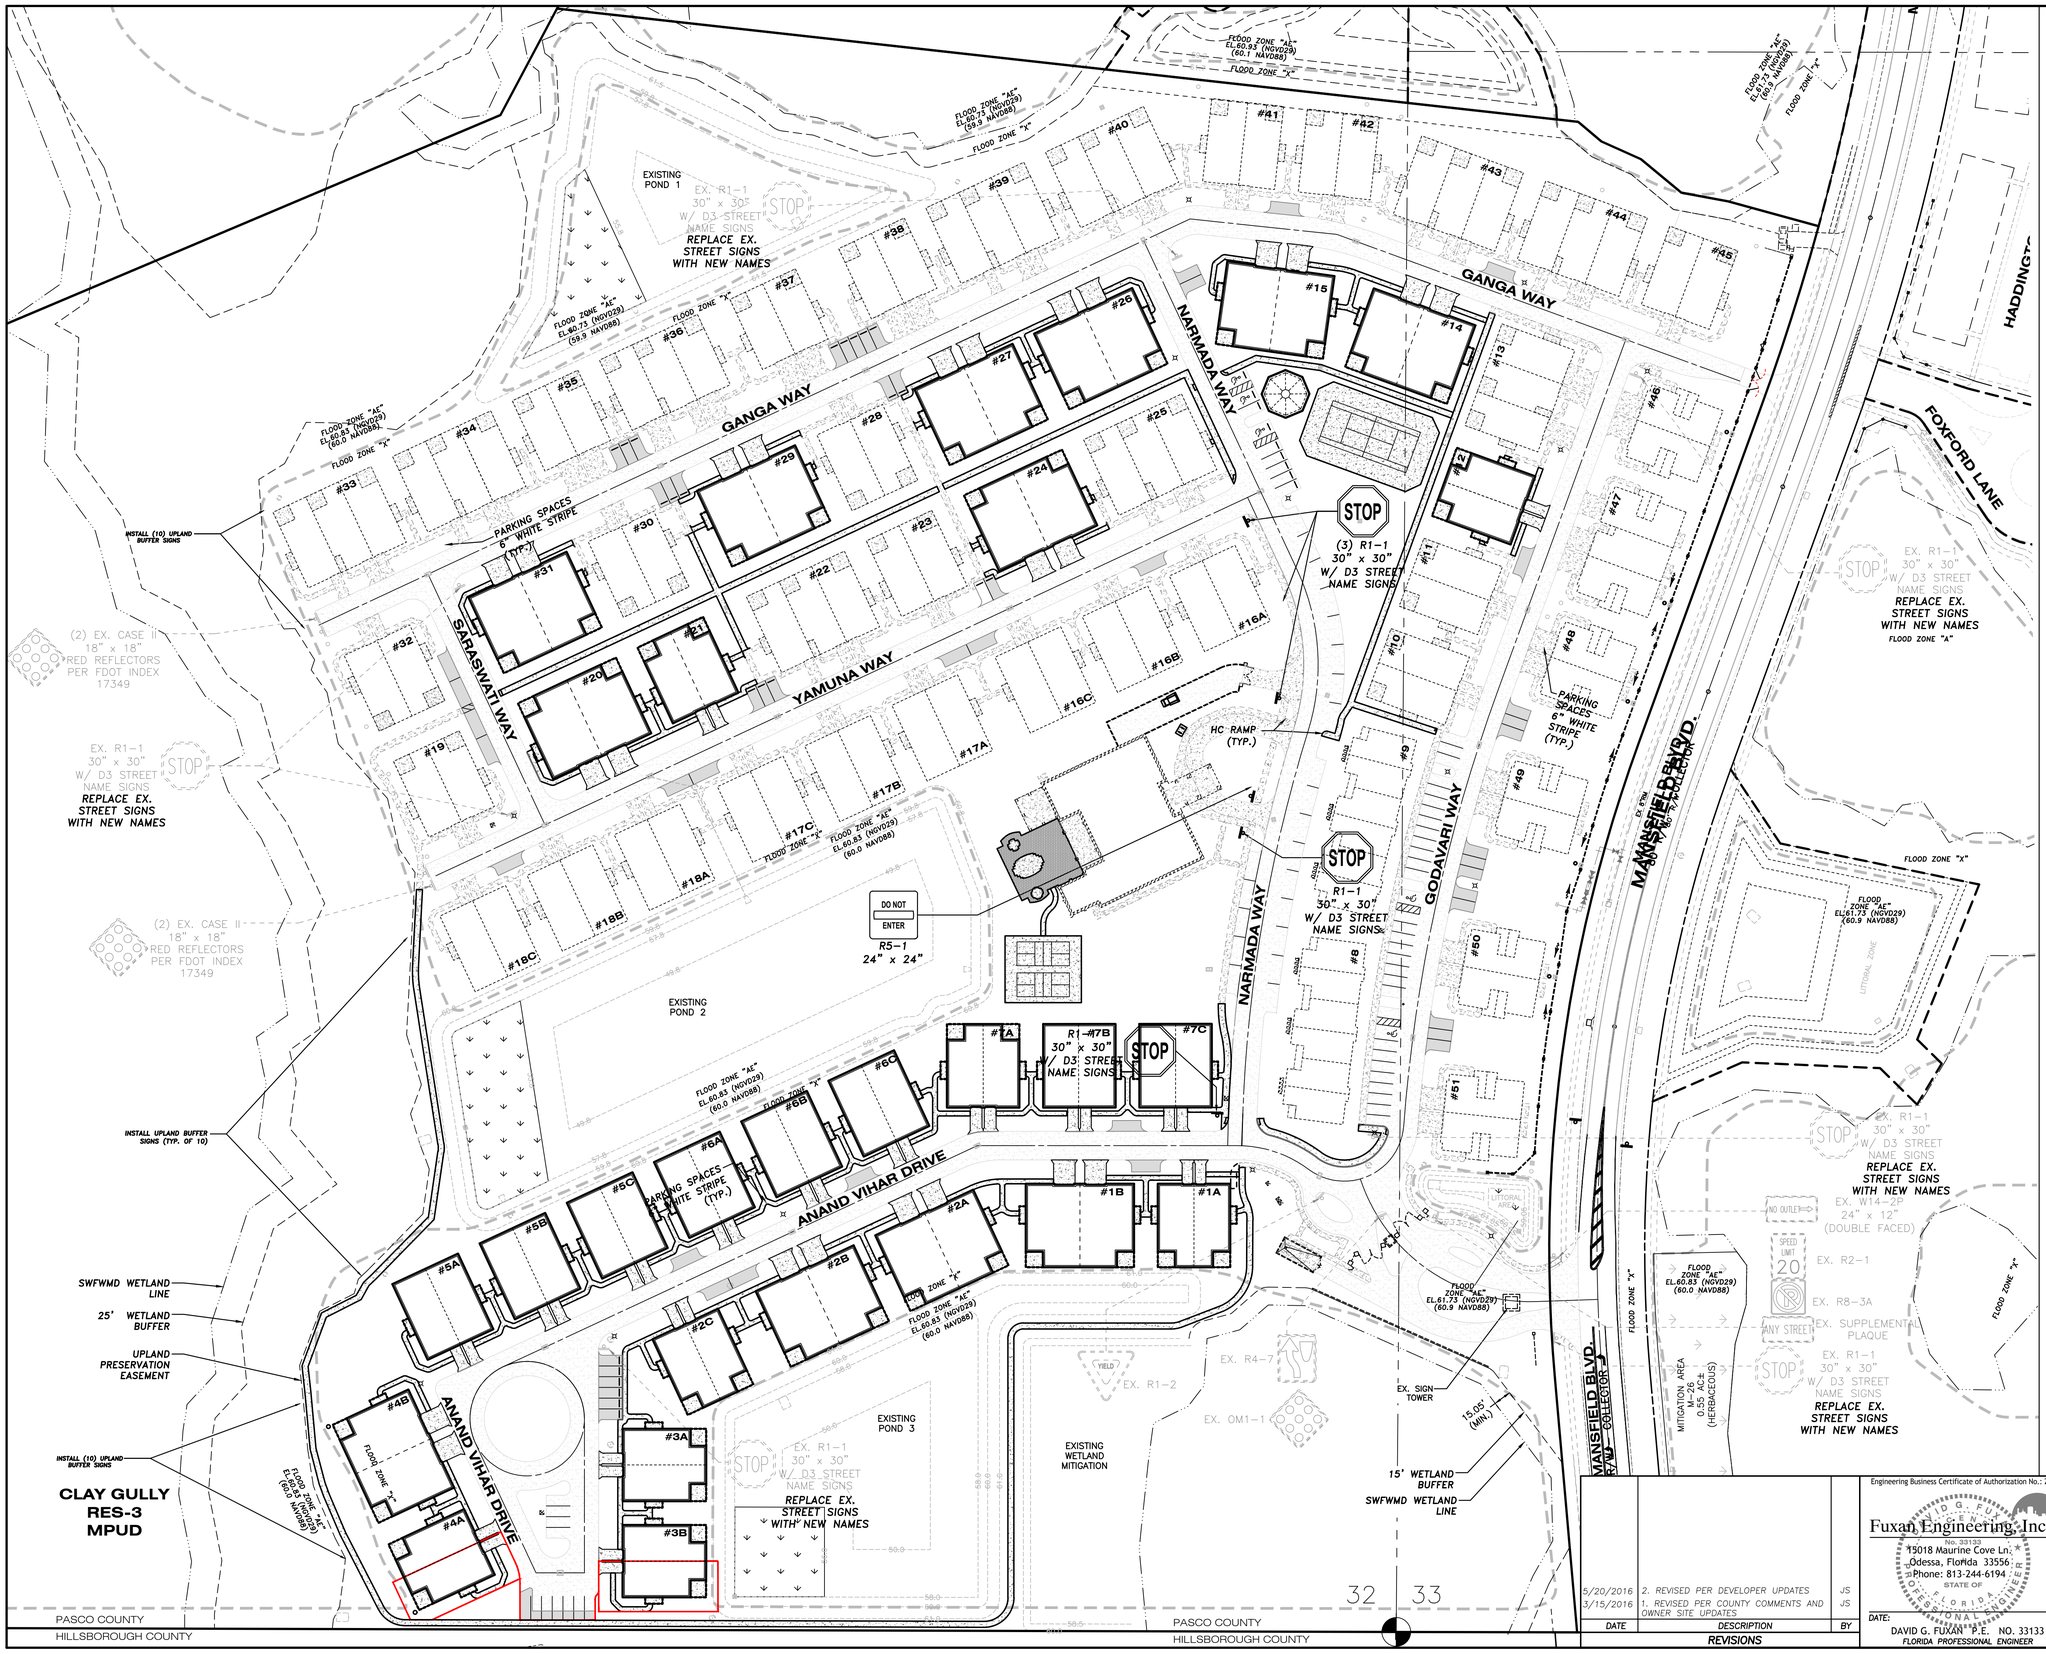

120 60 0 60 120

SCALE: 1" = 60'

SEE SHEET 2 FOR PASCO COUNTY STANDARD SITE PLAN NOTES

SEE SHEET 2 FOR SPECIFICATIONS FOR DESIGN AND INSTALLATION OF TRAFFIC CONTROL DEVICES

DATE	DESCRIPTION	BY
5/20/2016	2. REVISED PER DEVELOPER UPDATES	JS
3/15/2016	1. REVISED PER COUNTY COMMENTS AND OWNER SITE UPDATES	JS

REVISIONS

Engineering Business Certificate of Authorization No.: 26548

Fuxan Engineering, Inc.
15018 Maurine Cove Ln.
Odessa, Florida 33556
Phone: 813-244-6194

DAVID G. FUXAN P.E. NO. 33133
FLORIDA PROFESSIONAL ENGINEER

SIGNAGE & PAVEMENT MARKING PLAN

JOB NO. 2015-MP-01	ANAND VIHAR 2017 Redesign
DESIGN FUXAN	
DRAWN SOMERVILLE	PREPARED FOR: Anand Vihar, LLC
DATE 12-18-2015	Elevations based on National Geodetic Vertical Datum 1929 (NGVD 29) Conversion from NGVD 29 to NAVD 88 = -0.83 Feet
FILE SPM	SHEET 1 OF 1 SHEETS

ANAND VIHAR

#51

#1B

#1A

EX. 4' BIKE LANE

EX. 6" DOUBLE YELLOW

EX. 6" WHITE

EX. 4' BIKE LANE

BIKE LANE
R3-17

ENDS
R3-17BP

BIKE LANE
R3-17

11.0' THROUGH LANE

83' BIKE LANE TRANSITION

120' TRANSITION

11.0' THROUGH LANE

90' BIKE LANE TRANSITION

6" DOUBLE YELLOW

18" SOLID YELLOW
@ 10' O.C. (TYP.)

R30'

25.4'

22.8'

6" SOLID WHITE

WHITE LEFT TURN ARROWS PER
FDOT INDEX 17346 (TYP.)

11.0' THROUGH LANE

10.0' LEFT TURN LANE

MANSFIELD BLVD.
COLLECTOR
R/W

165' LEFT TURN LANE

LITTORAL AREA

WETLAND "53"
53
SH=60.05
NP=

61.0
60.0
58.0
60.0
61.0
58.5
60.0

PASCO COUNTY
HILLSBOROUGH COUNTY

11.0' THROUGH LANE

6" DOUBLE YELLOW

18" SOLID YELLOW
@ 10' O.C. (TYP.)

6" SOLID WHITE

12" SOLID WHITE CROSSWALK @ 7' O.C.

165' "TRANSITION"

138' BIKE LANE TRANSITION

TO EX. MEDIAN

6" DOUBLE YELLOW

18" SOLID YELLOW
@ 10' O.C. (TYP.)

6" SOLID WHITE

83' BIKE LANE TRANSITION

BIKE LANE
R3-17

BIKE LANE
R3-17

ENDS
R3-17BP

KINNAN ST.
120' R/W

EX. ENTRANCE #2

ISSUED:3/25/2015

REVISIONS

MANSFIELD BLVD
DESIGN SPEED 35 MPH

MANSFIELD BLVD TURN LANE NOTES:

1) REFLECTIVCE PAVEMENT MARKERS TO BE PLACED ALONG GUNN HIGHWAY PER FDOT INDEX #17352.

2) TURN LANE MARKINGS TO BE INSTALLED PER FDOT INDEX 17346.

3) ALL PAVEMENT MARKERS SHALL BE THERMOPLASTIC WITH RPM'S.

4) REMOVE ANY EXISTING STRIPING IN CONFLICT WITH THIS PLAN.

PREPARED BY:

Fuxan Engineering, Inc.

15018 Maurine Cove Ln.
Odessa, Florida 33556
Phone: 813-244-6194

Engineering Business Certificate of Authorization No.: 26548

PREPARED FOR:

Anand Vihar, LLC,
a Delaware LLC
4600 West Cypress Blvd.
Suite 120
Tampa, FL 3607

THIS DRAWING IS FOR GENERAL INFORMATION PURPOSES ONLY. ANY AND ALL FEATURES, MATTERS AND OTHER INFORMATION DEPICTED HEREON OR CONTAINED HEREIN ARE FOR ILLUSTRATIVE MARKETING PURPOSES ONLY, ARE SUBJECT TO MODIFICATION WITHOUT NOTICE, ARE NOT INTENDED TO BE RELIED UPON BY ANY PART AND ARE NOT INTENDED TO CONSTITUTE REPRESENTATIONS OR WARRANTIES AS TO OWNERSHIP OF THE REAL PROPERTY DEPICTED HEREON, THE SIZE AND NATURE OF IMPROVEMENTS TO BE CONSTRUCTED (OR THAT ANY IMPROVEMENTS WILL BE CONSTRUCTED) OR THE IDENTITY OR NATURE OF ANY OCCUPANTS THEREOF.

ANAND VIHAR
MEADOW POINTE
PARCEL 14-3 REDEVELOPMENT

OFFSITE ROADWAY MODIFICATION PLAN
Mansfield Boulevard
Tampa, Florida

0 30 60 90

SCALE: 1" = 30'

File Name: MP 14_ENGMAS.dwg Drawn By:jcs

ANAND VIHAR

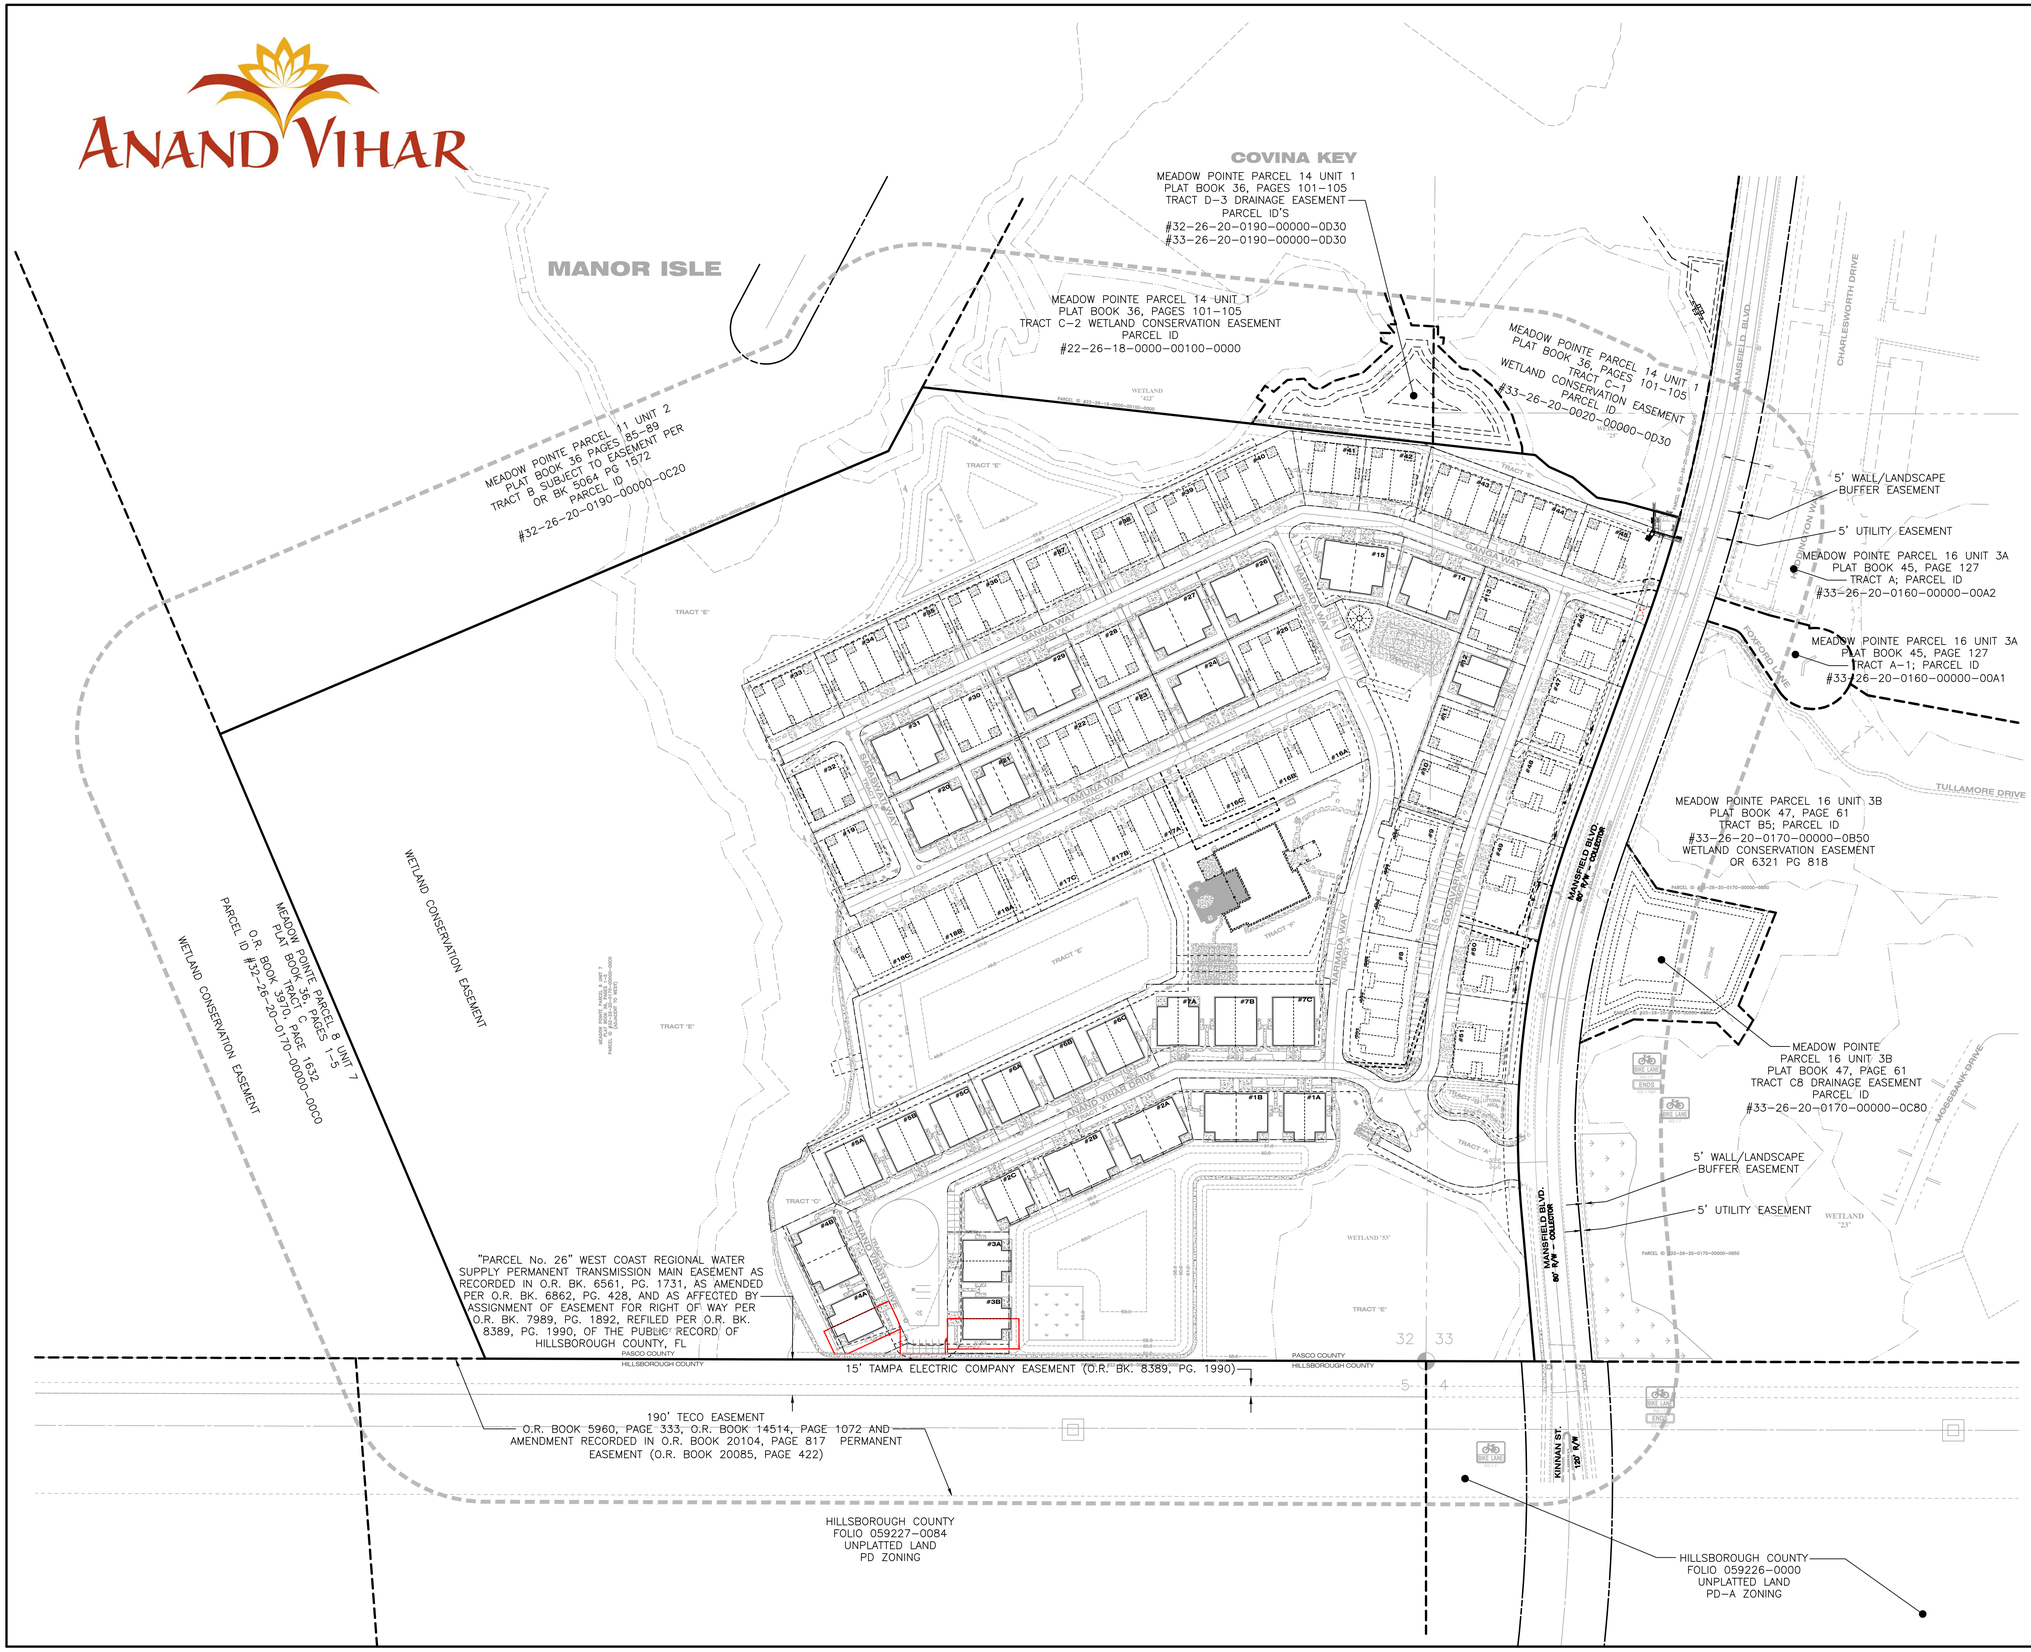

ISSUED:3/25/2015

REVISIONS

8/11/2016 - ADJUSTED AND ADDED DRAINAGE AND UTILITY EASEMENTS.
10/03/2016 - PASCO COUNTY PLAT REVISIONS - NO BASIN CHANGES
10/25/2017 - DEVELOPER REDESIGN

PREPARED BY:

Fuxan Engineering, Inc.

15018 Maurine Cove Ln.
Odessa, Florida 33556
Phone: 813-244-6194

Engineering Business Certificate of Authorization No.: 26548

PREPARED FOR:

Anand Vihar, LLC,
a Delaware LLC
4600 West Cypress Blvd.
Suite 120
Tampa, FL 3607

THIS DRAWING IS FOR GENERAL INFORMATION PURPOSES ONLY. ANY AND ALL FEATURES, MATTERS AND OTHER INFORMATION DEPICTED HEREON OR CONTAINED HEREIN ARE FOR ILLUSTRATIVE MARKETING PURPOSES ONLY, ARE SUBJECT TO MODIFICATION WITHOUT NOTICE, ARE NOT INTENDED TO BE RELIED UPON BY ANY PART AND ARE NOT INTENDED TO CONSTITUTE REPRESENTATIONS OR WARRANTIES AS TO OWNERSHIP OF THE REAL PROPERTY DEPICTED HEREON, THE SIZE AND NATURE OF IMPROVEMENTS TO BE CONSTRUCTED (OR THAT ANY IMPROVEMENTS WILL BE CONSTRUCTED) OR THE IDENTITY OR NATURE OF ANY OCCUPANTS THEREOF.

ANAND VIHAR
MEADOW POINTE
PARCEL 14-3 REDEVELOPMENT

EASEMENT EXHIBIT

Mansfield Boulevard
Tampa, Florida

0 100 200 300

SCALE: 1" = 100'

File Name: MP 14_ENGMAS.dwg Drawn By:jcs

ISSUED:6/27/2016

REVISIONS

7/26/2016 - UPDATE ENTRANCE BASIN TO MATCH PRIOR APPROVED - NO CHANGE PROPOSED
9/22/2016 - REVISED FOOTPRINTS BUILDINGS #1-#4 - NO BASIN CHANGES
10/03/2016 - PASCO COUNTY PLAT REVISIONS - NO BASIN CHANGES
10/25/2017 - DEVELOPER REDESIGN - NO BASIN CHANGES

PREPARED BY:

Fuxan Engineering, Inc.

15018 Maurine Cove Ln.
Odessa, Florida 33556
Phone: 813-244-6194

Engineering Business Certificate of Authorization No.: 26548

PREPARED FOR:

Anand Vihar, LLC,
a Delaware LLC

4600 West Cypress Blvd.
Suite 120
Tampa, FL 3607

THIS DRAWING IS FOR GENERAL INFORMATION PURPOSES ONLY. ANY AND ALL FEATURES, MATTERS AND OTHER INFORMATION DEPICTED HEREON OR CONTAINED HEREIN ARE FOR ILLUSTRATIVE MARKETING PURPOSES ONLY, ARE SUBJECT TO MODIFICATION WITHOUT NOTICE, ARE NOT INTENDED TO BE RELIED UPON BY ANY PART AND ARE NOT INTENDED TO CONSTITUTE REPRESENTATIONS OR WARRANTIES AS TO OWNERSHIP OF THE REAL PROPERTY DEPICTED HEREON, THE SIZE AND NATURE OF IMPROVEMENTS TO BE CONSTRUCTED (OR THAT ANY IMPROVEMENTS WILL BE CONSTRUCTED) OR THE IDENTITY OR NATURE OF ANY OCCUPANTS THEREOF.

ANAND VIHAR
MEADOW POINTE
PARCEL 14-3 REDEVELOPMENT

POST-DEV. DRAINAGE BASIN EXHIBIT
Mansfield Boulevard
Tampa, Florida

0 60 120 180

SCALE: 1" = 60'

File Name: MP 14-3.dwg Drawn By: jcs

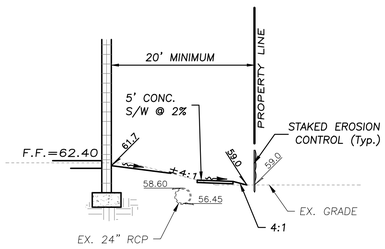

SECTION A–A

– NO SCALE –

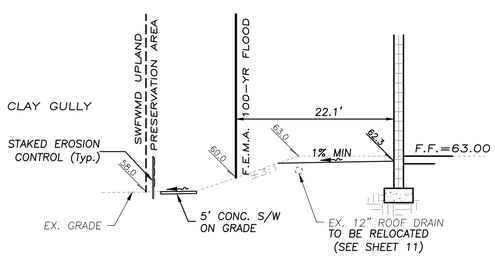

SECTION B–B

– NO SCALE –

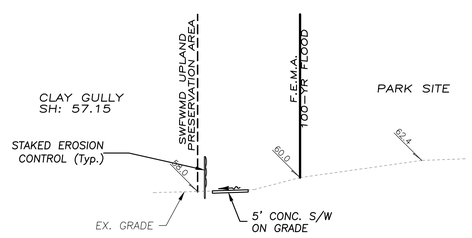

SECTION C–C

– NO SCALE –

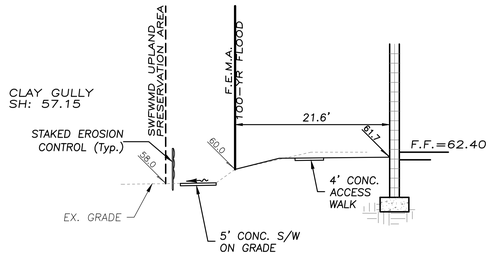

SECTION D–D

– NO SCALE –

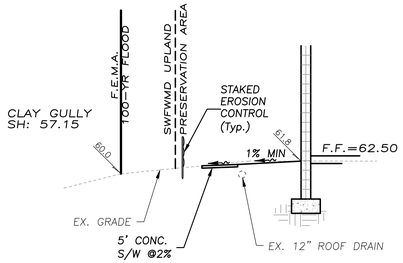

SECTION E–E

– NO SCALE –

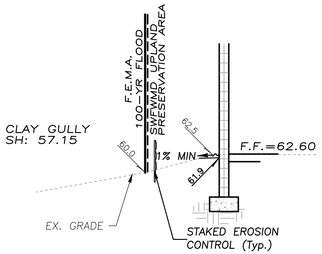

SECTION F–F

– NO SCALE –

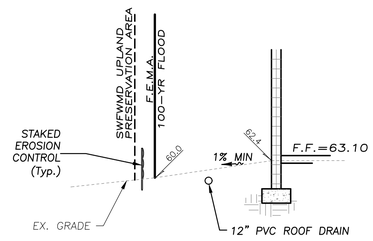

SECTION G–G

– NO SCALE –

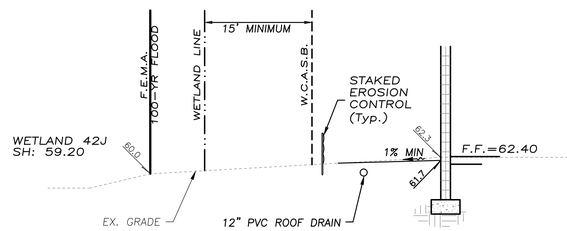

SECTION H–H

– NO SCALE –

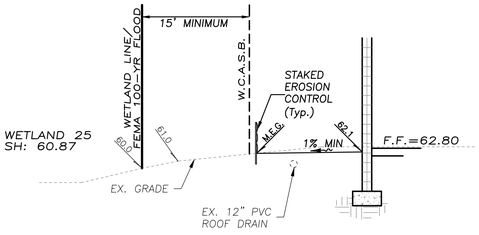

SECTION I–I

– NO SCALE –

SECTION K–K

– NO SCALE –

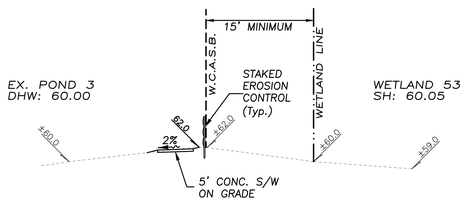

SECTION J–J

– NO SCALE –

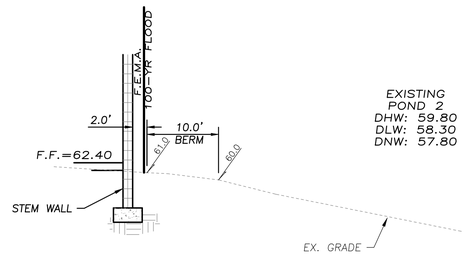

SECTION L–L

– NO SCALE –

NOTE:
SOD ALL SLOPES 4:1 AND STEEPER.

DATE	DESCRIPTION	BY
10/25/2017	3. UPDATES PER DEVELOPER REDESIGN	JS
12/14/2016	2. REVISED PER SITE GRADING UPDATES	JS
7/26/2016	1. ADDED CROSS SECTION K–K PER SWFWMD COMMENTS	JS

REVISIONS

Engineering Business Certificate of Authorization No.: 26548
Fuxan Engineering, Inc.
No. 33133
15018 Maurine Cove Ln.
Odessa, Florida 33556
Phone: 813-244-6194

DATE:

DAVID G. FUXAN P.E. NO. 33133
FLORIDA PROFESSIONAL ENGINEER

CROSS SECTIONS

JOB NO. 2015–MP–01	ANAND VIHAR 2017 Redesign
DESIGN FUXAN	
DRAWN SOMERVILLE	PREPARED FOR: Anand Vihar, LLC
DATE 06–27–2016	Elevations based on National Geodetic Vertical Datum 1929 (NGVD 29) Conversion from NGVD 29 to NAVD 88 = -0.83 Feet
FILE SEC	SHEET 1 OF 1 SHEETS